

STATE OF MICHIGAN  
DEPARTMENT  
OF  
NATURAL RESOURCES

LAND CORNER RECORD


LAKE COUNTY  
T 18 N R 13 W

DESCRIPTION OF CORNER South 1/4 - Section 12

CORNER MONUMENT Set std. dept. monument, buried 0.5' in E-W dirt road

DATE MONUMENT PLACED AND WITNESSED 6-30-72

WITNESSES TO CORNER..... Ctr. E-W rd. Due S 4'

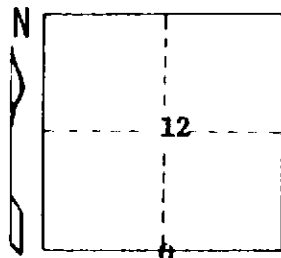

26" Oak N 21 E 65.6'


14" Oak N 38 W 31.2'

AND Set cedar post  
& locat@on tag Due N 33'

CIRCLE CORNER REGISTERED

DESCRIPTION IN DETAIL AS TO HOW CORNER WAS LOCATED AND IDENTIFIED OR RESTORED.

Re-established while making a retracement survey in this area. The corner was set on line between Section corners to East and West and in line with old line fence to South (mostly down) which fits within 8' of a corner by single proportion. The distance between Section corners is considerable short of U.S. distant (225'); therefore the fence line South, since it is near the split of the mile, was accepted to control the longitude of this corner.

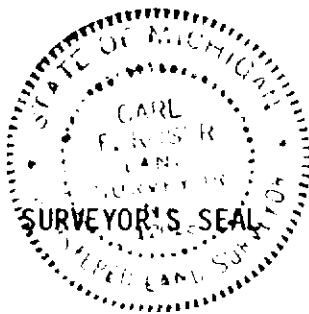

SIGNED

*Carl F. Boer* DATE

7-7-72

REGISTERED LAND SURVEYOR 12028

DISTRIBUTION:

Forestry Division, Lansing