

STATE OF MICHIGAN
DEPARTMENT
OF
NATURAL RESOURCES

LAND CORNER RECORD


LAKE COUNTY
T 13 R R 13 W

DESCRIPTION OF CORNER North 1/4 corner, Section 12

CORNER MONUMENT Set DWP monument and cedar guard post.

DATE MONUMENT PLACED AND WITNESSED 6-28-72

WITNESSES TO CORNER..... 13" Oak N 19 E 25.1'

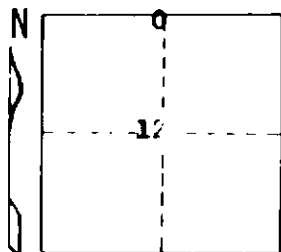

5" R. Pine N 78 W 32.3'


16" B. Oak S 33 W 7.7'

AND Ctr. E-W dirt Rd. Due S 92'

CIRCLE CORNER REGISTERED

DESCRIPTION IN DETAIL AS TO HOW CORNER WAS LOCATED AND IDENTIFIED OR RESTORED.

Corner re-established per standard BLM instructions.

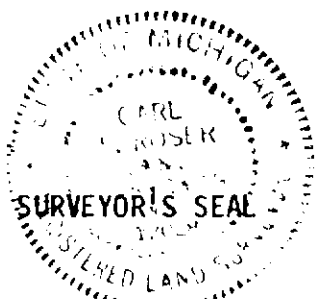

DISTRIBUTION:

Forestry Division, Lansing

SIGNED

Carl F. Rose

DATE

7-5-72

REGISTERED LAND SURVEYOR 12928