

STATE OF MICHIGAN
DEPARTMENT
OF
NATURAL RESOURCES

LAND CORNER RECORD


LAKE COUNTY
T 18 N R 13 W

DESCRIPTION OF CORNER NE corner of Section 12

CORNER MONUMENT Fd. 1" x 14" pipe. Added DNR monument.

DATE MONUMENT PLACED AND WITNESSED 6-28-72

WITNESSES TO CORNER..... 10" Oak S 45 E 95.4'

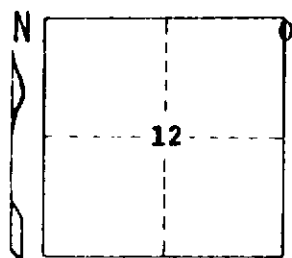

10" Oak N 67 E 81.1

9" Oak N 48 W 91.9'

10" J. Pine S 40 W 39.6'


Set ced. post Due W 33'

AND

CIRCLE CORNER REGISTERED

DESCRIPTION IN DETAIL AS TO HOW CORNER WAS LOCATED AND IDENTIFIED OR RESTORED.

Found recovered brass corner of record. Corner falls in approx. intersection of Sand Rds. N-S-F.

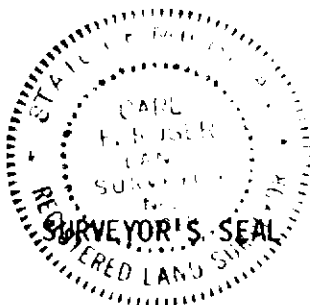

SIGNED

Carl F. Rose

DATE

7-5-72

DISTRIBUTION:

REGISTERED LAND SURVEYOR 12028

Forestry Division, Lansing