

STATE OF MICHIGAN  
DEPARTMENT  
OF  
NATURAL RESOURCES

LAND CORNER RECORD

LAKE COUNTY  
T 18 N R 13 W

DESCRIPTION OF CORNER NW corner of E1/2 - W1/2 - E1/2 - ~~SW~~ 1/4 of SE 1/4 of Sec. 12

CORNER MONUMENT Set 1" x 36" pipe and cedar guard post.


DATE MONUMENT PLACED AND WITNESSED 6-28-72

WITNESSES TO CORNER..... 9" Oak S 17 E 49.8'

10" Oak S 51 W 50.6'

Ctr. E-W Trail Rd. Due S 12'


AND

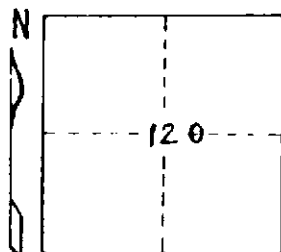

CIRCLE CORNER REGISTERED

DESCRIPTION IN DETAIL AS TO HOW CORNER WAS LOCATED AND IDENTIFIED OR RESTORED.

Established the NW corner of E 1/2 - W 1/2 - E 1/2 - ~~SW~~ 1/4 of SE 1/4 of Sec. 12-  
801.4' East of L-4 and 1763.1' West of M-4.

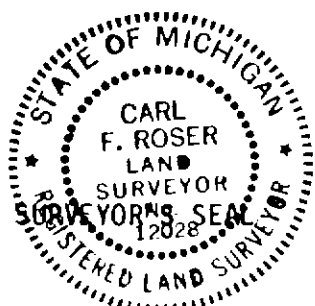

SIGNED

*Carl F. Roser*  
REGISTERED LAND SURVEYOR 12028

DATE

7-5-72

DISTRIBUTION:

Forestry Division, Lansing