

STATE OF MICHIGAN
DEPARTMENT
OF
NATURAL RESOURCES

LAND CORNER RECORD


LAKE COUNTY
T 18 N R 13 W

DESCRIPTION OF CORNER West 1/16 on E-W 1/4 line
CORNER MONUMENT Set 1" x 36" pipe buried 0.5' in N. wheel track of E-W dirt trail rd.
DATE MONUMENT PLACED AND WITNESSED 6-28-72

WITNESSES TO CORNER.....

12" J.P.	N 35 E	44.7'
18" Oak	N 30 W	60.4'
Set cedar post	Due N	33'


AND

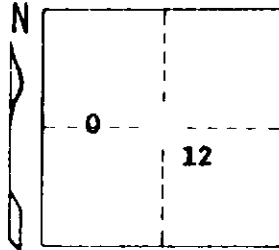

CIRCLE CORNER REGISTERED

DESCRIPTION IN DETAIL AS TO HOW CORNER WAS LOCATED AND IDENTIFIED OR RESTORED.

Corner established per standard BLM instructions.

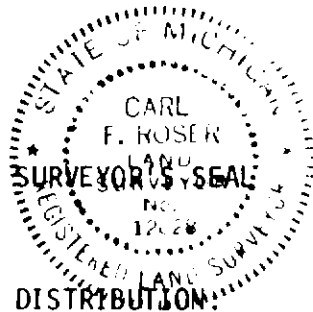

SIGNED

Carl F. Roser

REGISTERED LAND SURVEYOR

DATE

7-5-72

12028

Forestry Division, Lansing