

STATE OF MICHIGAN
DEPARTMENT
OF
NATURAL RESOURCES

LAND CORNER RECORD


LAKE COUNTY
T 18 N R 13 W

DESCRIPTION OF CORNER SW corner of E 1/2 - W 1/2 - E 1/2 - SW 1/4 - SE 1/4 of Sec. 12

CORNER MONUMENT Set 1" x 30" pipe in ctr. E-W dirt rd.

DATE MONUMENT PLACED AND WITNESSED 6-28-72

WITNESSES TO CORNER..... 6" J.P. N 59 E 64.0'

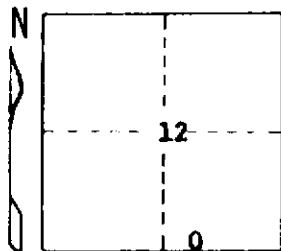

6" J.P. N 08 W 35.2'


Set cedar post Due N 33'

AND

CIRCLE CORNER REGISTERED

DESCRIPTION IN DETAIL AS TO HOW CORNER WAS LOCATED AND IDENTIFIED OR RESTORED.

**Established the SW corner of E 1/2 - W 1/2 - E 1/2 - SW 1/4 - SE 1/4 of Section 12
785.1' East of L-5 and 471.2' West of Cor. Code #16 (Sec. 12).**

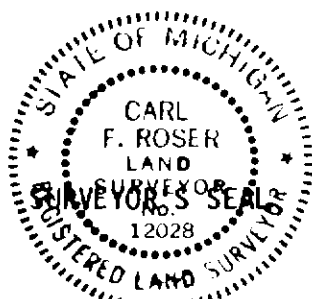

SIGNED

Carl F. Roser
REGISTERED LAND SURVEYOR 12028

DATE

7-5-72

DISTRIBUTION:

Forestry Division, Lansing