


STATE OF MICHIGAN  
DEPARTMENT  
OF  
NATURAL RESOURCES

LAND CORNER RECORD

LAKE COUNTY  
T 18 N R 13 W

DESCRIPTION OF CORNER East 1/4 Section 12  
CORNER MONUMENT Fd. 2" x 2" x 15" angle iron & added standard Dept. mon., buried 8"  
DATE MONUMENT PLACED AND WITNESSED 6-28-72


WITNESSES TO CORNER.....	17" B. Oak	N 42 E	52.0'
	20" Oak	S 69 E	75.7'
	16" J. Pine	S 36 E	56.3
	Set cedar post & location tag	Due E	33'
	AND CL N-S sand rd.	Due E	2'

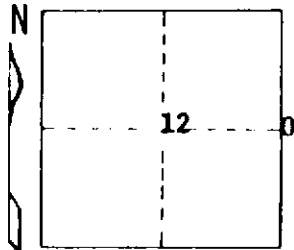

CIRCLE CORNER REGISTERED

DESCRIPTION IN DETAIL AS TO HOW CORNER WAS LOCATED AND IDENTIFIED OR RESTORED.

**Accepted recovered corner; fits very close to computed position by proportionate measurement.**

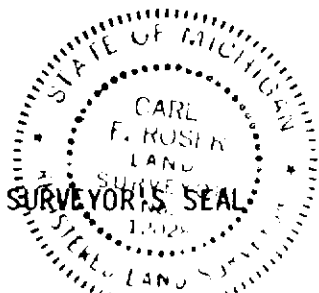

SIGNED

*Carl F. Rosen*

DATE

7-5-72

DISTRIBUTION:

REGISTERED LAND SURVEYOR 12028

Forestry Division, Lansing