LAND CORNER RECORDATION CERTIFICATE

Filing Requirement of Act 74, Mich. P.A. 1970

For corners in LAKE (County)

	Located In:	Corner Code #1
1. Public Land Survey	T 18N R 13W	K-2
	T R	
	T R	
	T R	
2. Property Controlling	S 2 T R	2, 7, 13
in Section	S T R	
3. Miscellaneous	S T R	
Property in Sec.	S T R	

Register of Deeds Stamp & File Number

4. Lot No. _____, Recorded Plat _____
5. Private Claims _____

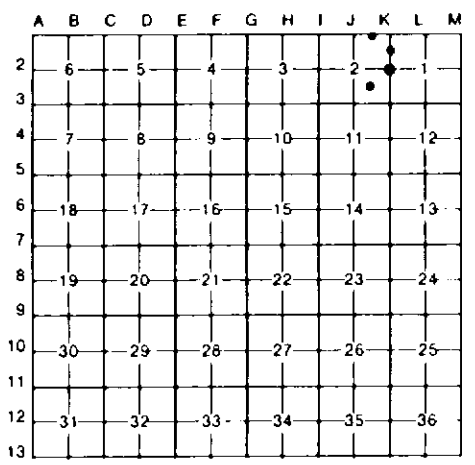

I, CARL F. ROSER, in a field survey on JUNE 11, 19 84, do hereby certify that under requirements of P.A. 74, Michigan P.A. of 1970, the corner points mentioned in lines 1 and 2 above were in conformance with regulations and rules therefore as required in the current manual of survey instructions of the United States Department of the Interior, Bureau of Land Management or by a decree of a Court of Law and/or that the corner points mentioned in lines 3, 4 and 5 above were in conformance with the rules of the Michigan Board of Land Surveyors or by a Decree of a Court of Law; established, re-established, monumented, re-monumented, recovered, found as expressed below

NOTE: Not more than 4 corners, all in the same town and range, may be recorded on this certificate.

A. Description of original monument and accessories and/or subsequent restoration:

K-2	2	7	13
COR IS PRVIOUS DEPT. COR OF RECORD, CFR 1972. COR WAS RE-ESTABILISHED PER STD BLM INSTRUCTIONS.	COR IS PREVIOUS DEPT COR OF RECORD, CFR 1972. THE MON WAS GONE 1984, RE-ESTABLISHED PER STD BLM INSTRUCTIONS.	FD 1" PIPE FOR NE COR OF SE 1/4-NE 1/4 OF SEC 2. COR IS PREVIOUS DEPT COR OF RECORD, CFR 1972. COR WAS ESTABLISHED PER STD BLM INSTRUCTIONS.	ESTABLISH NE COR, SW1/4, SE1/4, SEC 2 PER STD BLM INSTRUCTIONS.

B. Description of corner evidence found and/or method applied in restoring or reestablishing corner:

K-2

FD DNR MON & ADDED CED POST.

* 14" B. OAK	N 5°E	32.8'
* 14" B. OAK	S 50°E	44.1'
7" W. OAK	N 80°E	15.8'
6" W. OAK	S 70°W	3.0'

* EQUALS 1972 D.N.R. MITS

2

DROVE 3/4"X33" PIPE.

3" MAPLE	S 55°E	65.4'
6" R OAK	S 35°E	57.4'
4" W PINE	DUE S	45.1'
CTR E-W DIRT RD	DUE S	2'
SET CED POST W/LOC TAG BESIDE FD 1/2" IRON W/RLS CAP	DUE S	33.0'

7

FD 1"X36" PIPE, ADDED CED POST, W/ LOC TAG.

* 20" W OAK	N 65°W	65 3'
* 12" W OAK	S 50°W	33.8'
4" R OAK	S 35°E	19.3'

* EQUALS 1972 D.N.R. MIT

13

DROVE 5/8"X34" RE-ROD W/RLS CAP, SET CED POST W/LOC TAG.

10" W OAK	N 80°W	18.1'
3" W OAK	N 5°W	11.0'
9" R OAK	N 75°E	12.6'
3" R OAK	S 5°W	7.5'

C. Description of monument for corner and accessories established to perpetuate locating the position of the corner:

Signed by Carl F. Roser 03-16-88 Date

Surveyor's Michigan License No. 12028

STATE OF MICHIGAN
CARL F. ROSER
LAND SURVEYOR
No. 12028
REGISTERED LAND SURVEYOR

FORM APPROVED BY MICHIGAN STATE BOARD OF LAND SURVEYORS, JAN. 28, 1971
REVISED MAY 14, 1975
REVISED JAN., 1983