

SURVEY & REMONUMENTATION

JAN 12 1996

COMMISSION

LAND CORNER RECORDATION CERTIFICATE Filing Requirement of Act 74, Mich. P.A. 1970

LIBER 003 PAGE 0307

For corners in

Lake _____ (County)	Located In:	Corner Code =/≠
Public Land Survey	T 18N R 13W A-9 ✓ T 18N R 14W M-9	
Property Controlling in Section	S _____ T _____ R _____ S _____ T _____ R _____	
Miscellaneous Property in Sec.	S _____ T _____ R _____ S _____ T _____ R _____	

REGISTERED
 LAKE COUNTY, MI.
 SEP 5 3 05 PM '95
 REGISTER OF DEEDS
 Register of Deeds Stamp & File Number

Lot No. _____, Recorded Plat _____
 Private Claims _____

	A	B	C	D	E	F	G	H	I	J	K	L	M
2	6		5		4		3		2		1		
3													
4	7		8		9		10		11		12		
5													
6	18		17		16		15		14		13		
7													
8	19		20		21		22		23		24		
9													
10	30		29		28		27		26		25		
11													
12	31		32		33		34		35		36		
13													

Robert L. Wetherell in a field survey on August 17, 1995
 hereby certify that under requirements of P.A. 74, Michigan P.A. of 1970, the corner points mentioned in lines 1 and 2 above were in conformance with regulations and rules therefore as required in the current manual of survey instructions of the United States Department of the Interior, Bureau of Land Management or by a decree of a Court of Law and/or that the corner points mentioned in lines 3, 4 and 5 above were in conformance with the rules of the Michigan Board of Land Surveyors or by a Decree of a Court of Law; established, re-established, monumented, re-monumented, recovered, found as expressed below:

NOTE: Not more than 4 corners, all in the same town and range, may be recorded on this certificate.

Description of original monument and accessories and/or subsequent restoration:
 A-9 & M-9 - Corner common to Sections 19 & 30, T18N, R13W AND Sections 24 & 25, T18N, R14W, Lake Co., Mi.

- | | | |
|-------------------------------------|--|------------------------------|
| 1838 - Mullett & Brookfield, G.L.O. | Undated - George H. Johnson (1905-1915) Co. Sur. | 1963 - George Blass, LS 5489 |
| #1 - 10" W. Pine S68°W 62 Links | #3 - 12" B. Oak S64°W 96 Links | Set 1" x 36" Pipe from |
| #2 - 12" W. Pine N82°W 1.02 Chains | #4 - 12" B. Oak N70°W 59 Links | George Johnson's witnesses |
| | | #5 - 18" W. Oak N43°E 50.40' |
| | | #6 - 20" R. Oak S75°E 93.10' |
| | | #7 - 18" B. Oak S70°W 38.30' |
| | | #8 - W. Pine N33°W 54.35' |

(SEE OVER FOR CONTINUATION OF "A")

Description of corner evidence found and/or method applied in restoring or reestablishing corner:

A-9 & M-9 - Corner common to Sections 19 & 30, T18N, R13W AND Sections 24 & 25, T18N, R14W, Lake Co., Mi.

I found a 4" x 36" Concrete Monument with Brass Cap (marked "Blass Survey") in the intersection of roads North and South and East. I recovered all of Blass's accessories #5 thru #8 inclusive, and all of Griffin's #5 thru #10 inclusive. Accessories #1 thru #4 inclusive have been destroyed. I recovered Kennitz irons South and East (from survey recorded in Liber 01, Page 563) and checked his distances well.


Description of monument for corner and accessories established to perpetuate locating the position of the corner:

A-9 & M-9 - Corner common to Sections 19 & 30, T18N, R13W AND Sections 24 & 25, T18N, R14W, Lake Co., Mi.

I left the 4" x 36" Brass Capped Monument as found, and is accepted as a careful and faithful re-establishment of the position of the original corner.

- 24" Forked W. Oak N44°E 51.00' (dock spike in N.W. side) O.B.T. #5
- 26" B. Oak S71°E 93.44' (dock spike in N.E. side) O.B.T. #6
- 23" B. Oak S74°W 39.05' (dock spike in N.W. side) O.B.T. #7
- 14" W. Pine N34°W 54.44' (60d spike in W. side) O.B.T. #8

Signed by Robert L. Wetherell Date August 29, 1995
 24624

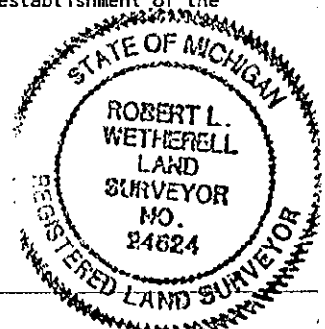

JAN 1 2 1996

COMMISSION

CONTINUATION OF "A" - DESCRIPTION OF ORIGINAL MONUMENT AND ACCESSORIES AND/OR SUBSEQUENT RESTORATION:

LIBER 003 PAGE 0308

1964 - George Blass, LS 5489

Subdivided the N.E.1/4, Sec. 25, T18N, R14W
into the plat of "Nugent Lake Hills".

The N.E. corner of this plat being the
Section corner. Replaced pipe with
Concrete Monument.

1964 - Robert A. Griffin, LS 13584

L.C.R.C. - Liber 01, Page 145

#5 - 21" W. Oak N43°E 50.92'

#6 - 20" B. Oak S75°E 93.43'

#7 - 17" B. Oak S70°W 39.05'

#9 - Cedar Post N82°W 34.25'

#10 - 4" Concrete Monument N82°W 33.28'

1975 - Harry Kemnitz, LS 16931

Recorded survey in Liber 01 Page 563.

Used corner to divided the N.W.1/4,
Sec. 30, T18N, R13W, (no monument or
witnesses given).