

SURVEY & REMONUMENTATION

JAN 1 2 1996

COMMISSION

**LAKE COUNTY REMONUMENTATION
LAND CORNER RECORDATION CERTIFICATE
Filing Requirement of Act 74, Mich. P.A. 1970**

LIBER 003 PAGE 0309

For corners in

Lake (County)	Located In:		Corner Code #
	18N	13W	
Public Land Survey	T	R	B-9
	T	R	
	T	R	
	T	R	
Property Controlling in Section	S	T	R
	S	T	R
Miscellaneous Property in Sec.	S	T	R
	S	T	R

REGISTER OF DEEDS

Register of Deeds

SEP 5 3 05 PM '95

RECORDED
LAKE COUNTY, MI.

Register of Deeds Stamp & File Number

Lot No. _____, Recorded Plat _____
Private Claims _____

Robert L. Wetherell August 17, 1995

I hereby certify that under requirements of P.A. 74, Michigan P.A. of 1970, the corner points mentioned in lines 1 and 2 above were in conformance with regulations and rules therefore as required in the current manual of survey instructions of the United States Department of the Interior, Bureau of Land Management or by a decree of a Court of Law and/or that the corner points mentioned in lines 3, 4 and 5 above were in conformance with the rules of the Michigan Board of Land Surveyors or by a Decree of a Court of Law; established, re-established, monumented, re-monumented, recovered, found as expressed below:

NOTE: Not more than 4 corners, all in the same town and range, may be recorded on this certificate.

	A	B	C	D	E	F	G	H	I	J	K	L	M
2	6	5	4	3	2	1							
3													
4	7	8	9	10	11	12							
5													
6	18	17	16	15	14	13							
7													
8	19	20	21	22	23	24							
9	●												
10	30	29	28	27	26	25							
11													
12	31	32	33	34	35	36							
13													

A. Description of original monument and accessories and/or subsequent restoration:

B-9 - 1/4 Corner common to Sections 19 & 30, T18N, R13W, Webber Twp., Lake Co., Mi.

1838 - Sylvester Sibley, G.L.O.
8" Pine for corner tree 32.32 Chains
from Northwest Section Corner.

1963 - George Blass, LS 5489
Working in Section 19, T18N, R13W shows corner being at a G.L.O. proportionate distance between Section corners 2060.77' to Southwest corner Sec. 19 AND 2550.45' to S.E. cor. Sec. 19.
No monument or witnesses given.

(SEE OVER FOR CONTINUATION OF "A")

B. Description of corner evidence found and/or method applied in restoring or reestablishing corner:

B-9 - 1/4 Corner common to Sections 19 & 30, T18N, R13W, Webber Twp., Lake Co., Mi.

I set the corner on line between the respective Section corners at proportionate distance to G.L.O. measurement. I measured the total distance at 4608.43 feet. G.L.O. reported a distance of 4773.12 feet with the closing half mile being 2133.12 feet. I set the corner 2548.91 feet from the Northeast corner of Section 30 and 2059.52 feet from the Northwest corner of Section 30. The corner falls in the center of an East and West gravel road. While digging the hole to place the monument, I found an old rotted wood stake, unknown origin.

RATIFIED BY THE LAKE CO. PEER REVIEW GROUP
IN ACCORDANCE WITH PA. 345
CHAIRMAN R. W.
DATE 8-29-95

C. Description of monument for corner and accessories established to perpetuate locating the position of the corner:

B-9 - 1/4 Corner common to Sections 19 & 30, T18N, R13W, Webber Twp., Lake Co., Mi.


I placed a 3/4" x 24" re-bar with Lake County Brass Cap, and is accepted as a careful and faithful re-establishment of the position of the original corner.

- 10" B. Oak N62°E 66.77' (60d spike in N.W. side)
- 11" W. Oak N1°W 56.17' (60d spike in W. side)
- 10" B. Oak S15°W 50.94' (60d spike in E. side)
- 7" B. Oak S23°E 89.60' (60d spike in N.E. side)

Signed by Robert L. Wetherell

Date August 29, 1995

Surveyor's Michigan License No. 24624

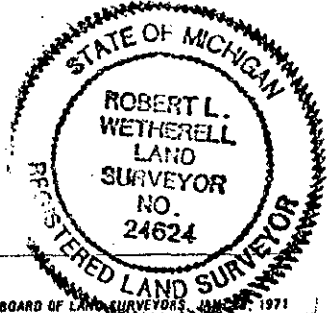

CONTINUATION OF "A" - DESCRIPTION OF ORIGINAL MONUMENT AND ACCESSORIES AND/OR SUBSEQUENT RESTORATION:

1975 - Harry Kemnitz, LS 16931

Recorded survey in Liber 01, Pages 563 & 564.

He did not indicate a position for this corner.

He did, however, monument the North and South 1/4

line from the South 1/4 corner of Section 30 to

a point 2630.22 feet North of said S.1/4 corner.

By extending this line North to the North Section line,

the distance to the N.E. corner of said Section 30

is 2640 feet.

1980 - Robert L. Wetherell, LS 24624

Working in Section 19, used Blass's position for

this corner to do a survey on the North and South 1/4 Line

in the N.W.1/4 of the N.E.1/4. Did not set this corner.

LIBER 003 PAGE 0310

SURVEY &
MONUMENTATION

JAN 12 1996

COMMISSION