

**SURVEY & REMONUMENTATION**

JAN 1 2 1996


**COMMISSION**

**LAKE COUNTY REMONUMENTATION  
LAND CORNER RECORDATION CERTIFICATE**  
Filing Requirement of Act 74, Mich. P.A. 1970

LIBER003 PAGE 0311

For corners in

Lake (County)	Located In:		Corner Code #
	18N	13W	
Public Land Survey	T	R	C-9
	T	R	
	T	R	
	T	R	
Property Controlling in Section	S	T R	
	S	T R	
Miscellaneous Property in Sec.	S	T R	
	S	T R	

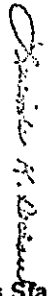  
 REGISTER OF DEEDS  
 SEP 5 3 05 PM '95  
 RECORDED  
 LAKE COUNTY, MI.  
 Register of Deeds Stamp & File Number

Lot No. \_\_\_\_\_, Recorded Plat \_\_\_\_\_  
Private Claims \_\_\_\_\_

Robert L. Wetherell August 17, 1995  
in a field survey on \_\_\_\_\_, 19\_\_\_\_\_,  
I hereby certify that under requirements of P.A. 74, Michigan P.A. of 1970, the corner points mentioned in lines 1 and 2 above were in conformance with regulations and rules therefore as required in the current manual of survey instructions of the United States Department of the Interior, Bureau of Land Management or by a decree of a Court of Law and/or that the corner points mentioned in lines 3, 4 and 5 above were in conformance with the rules of the Michigan Board of Land Surveyors or by a Decree of a Court of Law; established, re-established, monumented, re-monumented, recovered, found as expressed below:

	A	B	C	D	E	F	G	H	I	J	K	L	M
2	6	5	4	3	2	1							
3													
4	7	8	9	10	11	12							
5													
6	16	17	16	15	14	13							
7													
8	19	20	21	22	23	24							
9													
10	30	29	28	27	26	25							
11													
12	31	32	33	34	35	36							
13													

**NOTE:** Not more than 4 corners, all in the same town and range, may be recorded on this certificate.

Description of original monument and accessories and/or subsequent restoration:

<u>C-9 - Section corner common to sections 19, 20, 29 &amp; 30, T18N, R13W, Webber Twp., Lake Co., Mi.</u>		
1838 - Sylvester Sibley, G.L.O.	Co. Sur. Records (undated)	1966 - Robert A. Griffin, LS 13584
#1 - 12" Pine S71°E 1.10 Chains	Iron	L.C.R.C. - Liber 02, Page 432
#2 - 12" Pine N58°W 64 Links	#3 - 8" W. Oak N29°15'W 112 Links	Found iron From George H. Johnson
1908 - J.W. Nicholson, Co. Sur.	#5 - 9" B. Oak S52°30'W 25'	Witnesses:
#3 - 8" W. Oak N29°15'W 112-1/4 Links	Undated - G. Johnson, Co. Sur.	#7 - 6" W. Oak N15°W 56.72'
#4 - 12" Pine S71°E 110 Links	Iron	#8 - 8" W. Pine N38°W 92.58'
	#5 - 9" B. Oak S52°30'W 25'	#9 - 7" B. Oak N28°W 111.11'
	#6 - 9" B. Oak N82°30'E 72'	Replaced iron with 5" Conc. Monument


Description of corner evidence found and/or method applied in restoring or reestablishing corner:

C-9 - Section corner common to sections 19, 20, 29 & 30, T18N, R13W, Webber Twp., Lake Co., Mi.  
I found a 5" Square Concrete Monument 7 feet more or less South of the center of an East and West gravel road. Condition of the accessories are as follows: #1 Gone, #2 Gone, #3 Gone, #4 Gone, #5 Found Stump, #6 Gone, #7 Found in condition N15°E NOT N15°W, #8 Found in good condition, #9 Found in good condition.

RATIFIED BY THE LAKE CO. PEER REVIEW GROUP  
IN ACCORDANCE WITH P.A. 345  
CHAIRMAN G. X. W.  
DATE 8-29-95

Description of monument for corner and accessories established to perpetuate locating the position of the corner:

C-9 - Section corner common to sections 19, 20, 29 & 30, T18N, R13W, Webber Twp., Lake Co., Mi.  
I accepted the 5" Square Concrete Monument as a substantial marker for the corner, and is accepted as a careful and faithful re-establishment of the position of the original corner.  
8" W. Oak N15°E 56.72' (dock spike in E. side) #7  
8" W. Pine N37°W 92.58' (nail and washer in E. side) #8  
9" B. Oak N28°W 111.11' (dock spike in N.E. side) #9  
4" x 4" Treated Pine Post North 32.97' (nail and washer in E. side)

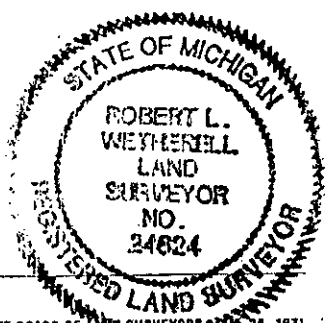

Signed by Robert L. Wetherell Date August 29, 1995  
24624