

**SURVEY & REMONUMENTATION**

**JAN 25 2001 LAND CORNER RECORDATION CERTIFICATE**  
 FILING REQUIREMENT OF ACT 74, Mich. P.A. 1970

**SECTION**

For corners in Lake _____	Located in:	Corner Code#
1. Public Land Survey	T 18 N R 13 W	C-11
	T R	
	T R	
	T R	
2. Property Controlling in Section	S T R	
	S T R	
3. Miscellaneous Property in Sec.	S T R	
	S T R	
4. Lot No. _____ Recorded Plat _____		
5. Private Claims _____		

RECORDED  
 LAKE COUNTY, MI.  
 LIBER 004 PAGE 0270

DEC 8 11 20 AM '00

*Shelley Myers*

REGISTER OF DEEDS  
 Register of Deeds Stamp & File Number

	A	B	C	D	E	F	G	H	I	J	K	L	M
1													
2	6	5	4	3	2	1							
3													
4	7	8	9	10	11	12							
5													
6	18	17	16	15	14	13							
7													
8	19	20	21	22	23	24							
9													
10	30	29	28	27	26	25							
11													
12	31	32	33	34	35	36							
13													

I, Robert L. Wetherell, in a field survey on February 22, 2000, do hereby certify that under requirements of P.A. 74, Michigan P.A. of 1970, the corner points mentioned in lines 1 and 2 above were in conformance with regulations and rules therefore as required in the current manual of survey instructions of the United States Department of the Interior, Bureau of Land Management or by decree of a Court of Law and/or that the corner points mentioned in lines 3, 4, and 5 above were in conformance with the rules of the Michigan Board of Land Surveyors or by a Decree of a Court of Law; established, re-established, monumented, re-monumented, recovered, found as expressed below:

**C-11 - Section corner common to Sections 29, 30, 31 & 32, T18N, R13W**

**A. Description of original monument and accessories and/or subsequent restoration:**

1838 - S. Sibley, G.L.O.

#1 - 10" W. Oak N73°W 59 Links  
 #2 - 8" W. Oak S70°E 42 Links

1925 - G.H. Johnson, Co. Sur.

"Iron"  
 #3 - 10" B. Oak N68°W 28'  
 #4 - 10" W. Oak N55°E 59'  
 Measured 5032' - South

1977 - C. Cole, LS 17615

Used corner to set the 1/4 corner common to Section's 31 & 32.  
 Lakestate Surveyors File No. 2800-77

**B. Description of corner evidence found and/or method applied in restoring of reestablishing corner:**

I found a 3/4" x 20" Chisel along side a steel fence post. Corner is in line with fence to South and West. I measured 4993.08 feet South to the Southwest corner of Section 32.


Condition of the accessories are as follows: #1 gone, #2 Gone, #3 Found in good condition, #4 Gone

**C. Description of monument for corner and accessories established to perpetuate locating the position of the corner:**

I replaced the 3/4" Chisel with a 3/4" x 24" re-bar with Lake County Remon Cap and is accepted as a careful and faithful reestablishment Of the position of the original corner.

11" W. Oak S47°E 57.62' (Found dock spike in North side)  
 14" W. Oak N46°E 56.51' (set 60d spike in West side)  
 6" W. Oak N03°W 55.74' (Found dock in West side)  
 14" B. Oak N63°W 28.01' (Set 60d spike in South side) #3  
 11" W. Pine S57°W 91.19' (set 60 spike in S.E. side)

RATIFIED BY THE LAKE CO. PEER REVIEW GROUP  
 IN ACCORDANCE WITH P.A. 345  
 CHAIRMAN *R&W*  
 DATE 12-5-2000

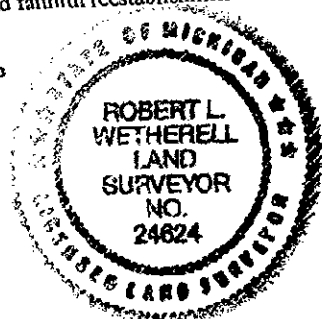

Signed by Robert L. Wetherell

Date December 6, 2000

Surveyor's Michigan License No. 24624