

MAY 18 1998

SECTION

LAND CORNER RECORDATION CERTIFICATE
Filing Requirement of Act 74, Mich. P.A. 1970

LIBER 004 PAGE 0123

For corners in
Lake

Located In:

Corner Code #

(County)	Located In:	Corner Code #
1. Public Land Survey	T <u>18N</u> R <u>13W</u>	E-11
	T <u> </u> R <u> </u>	<u> </u>
	T <u> </u> R <u> </u>	<u> </u>
	T <u> </u> R <u> </u>	<u> </u>
2. Property Controlling in Section	S <u> </u> T <u> </u> R <u> </u>	<u> </u>
	S <u> </u> T <u> </u> R <u> </u>	<u> </u>
3. Miscellaneous Property in Sec.	S <u> </u> T <u> </u> R <u> </u>	<u> </u>
	S <u> </u> T <u> </u> R <u> </u>	<u> </u>

REGISTER OF DEEDS

RECORDED
LAKE COUNTY, MI.

Apr 14 3 04 PM '98

Register of Deeds Stamp & File Number

4. Lot No. _____, Recorded Plat _____
 5. Private Claims _____

I, Robert L. Wetherell, in a field survey on Jan. 20, 1998 do hereby state that under requirements of P.A. 74, Michigan P.A. of 1970, the corner points mentioned in lines 1 and 2 above were in conformance with regulations and rules therefore as required in the current manual of survey instructions of the United States Department of the Interior, Bureau of Land Management or by a decree of a Court of Law and /or that the corner points mentioned in lines 3, 4 and 5 above were in conformance with the rules of the Michigan Board of Land Surveyors or by a Decree of a Court of Law; established, re-established, monumented, recovered, found as expressed below:

NOTE: Not more than 2 corners, all in the same town and range, may be recorded on this certificate.

	A	B	C	D	E	F	G	H	I	J	K	L	M
1													
2	6		5		4		3		2		1		
3													
4	7		8		9		10		11		12		
5													
6	18		17		16		15		14		13		
7													
8	19		20		21		22		23		24		
9													
10	30		29		28		27		26		25		
11													
12	31		32		33		34		35		36		
13													

A. Description of original monument and accessories and/or subsequent restoration:

E-11 - Section corner common to Sections 28, 29, 32 & 33, T18N, R13W, Webber Twp., Lake Co., Mi.

1838 - S. Sibley, G.L.O.

#1 - 12" Pine S29°W 19 Links

#2 - 10" Pine N72°E 4 Links

1908 - George West, Deputy Co. Sur.

"Identified corner by remains of old witness trees and fence corner".

#3 - 6" B. Oak S86°30'W 34-1/2 Links

#4 - 7" W. Oak N42°45'E 42-1/2 Links

Undated County Survey Records

#5 - 6" B. Oak N39°45'E 90-1/2 Links

#6 - 6" B. Oak S16°W 115-1/4 Links

(SEE OVER FOR CONTINUATION OF "A")

B. Description of corner evidence found and/or method applied in restoring or reestablishing corner:

E-11 - Section corner common to Sections 28, 29, 32 & 33, T18N, R13W, Webber Twp., Lake Co., Mi.

I found Griffin's 5" Concrete Monument 38 feet East of North and South road, and 38 feet South of East and West road.

Condition of the accessories are as follows: #1 Gone, #2 Gone, #3 Gone, #4 Gone, #5 Gone, #6 Found in good condition, #7 Found in good condition, #8 Found in good condition, #9 Found in good condition, #10 Found in good condition, #11 Found Stump, #12 Found in good condition.

RATIFIED BY THE LAKE CO. PEER REVIEW GROUP
IN ACCORDANCE WITH P.A. 345

CHAIRMAN R.L.W.

DATE 4-9-98

C. Description of monument for corner and accessories established to perpetuate locating the position of the corner:

E-11 - Section corner common to Sections 28, 29, 32 & 33, T18N, R13W, Webber Twp., Lake Co., Mi.

I accepted the 5" Concrete Monument as a substantial marker for the corner, and is accepted as a careful and faithful re-establishment of the position of the original corner.

9" W. Oak N71°E 14.87' (60d spike in N. side) #7


14" B. Oak S45°E 25.11' (60d spike in S.W. side) #12

16" B. Oak S42°W 47.15' (60d spike in S.E. side) #8

30" B. Oak N65°W 60.10' (60d spike in S. side) #9

Signed by Robert L. Wetherell
 Surveyor's Michigan License No. 24624

Date 4-14-98

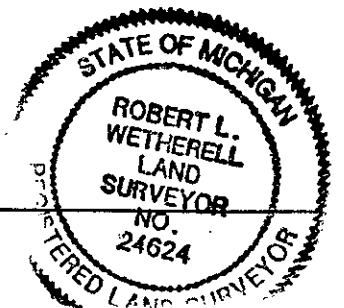

CONTINUATION OF "A" - DESCRIPTION OF ORIGINAL MONUMENT AND ACCESSORIES AND/OR SUBSEQUENT RESTORATION:

1953 - G. Blass, LS 5489

Found 1-1/4" Well point with broken glass and old wood stake.

- #7 - 6" W. Oak N61°E 14.65'
- #8 - 14" B. Oak S35°W 47.00'
- #9 - 16" B. Oak N70°W 60.00'

1972 - Robert Griffin, LS 13584

L.C.R.C. - Liber 02, Pg. 82

Found well point. Replaced with 5" Concrete Monument.

- #10 - 8" B. Oak S61°E 103.76'
- #11 - 5" B. Oak N31°E 93.44'
- #7 - 6" W. Oak N61°E 14.74'

1995 - Robert L. Wetherell, LS 24624

- #7 - 9" W. Oak N71°E 14.87'
- #12 - 14" B. Oak S45°E 25.11'
- #8 - 16" B. Oak S42°W 47.15'
- #9 - 30" B. Oak N65°W 60.10'

SURVEY &
REMONUMENTATION

MAY 18 1998

SECTION