

MAY 16 1997

COMMISSION


LIBER003 PAGE0391

LAND CORNER RECORDATION CERTIFICATE
Filing Requirement of Act 74, Mich. P.A. 1970

Form with fields for 'For corners in Lake', 'Located In: 18N, 13W', 'Corner Code: F-3', and numbered sections 1-5 for survey details.

RECORDED LAKE COUNTY, MI.
REGISTER OF DEEDS
Nov 14 11 25 AM '96

Register of Deeds Stamp & File Number

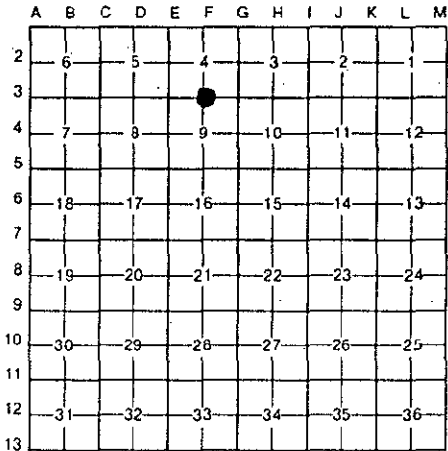

Robert L. Wetherell August 7, 1996
I, in a field survey on do hereby certify that under requirements of P.A. 74, Michigan P.A. of 1970, the corner points mentioned in lines 1 and 2 above were in conformance with regulations and rules therefore as required in the current manual of survey instructions of the United States Department of the Interior, Bureau of Land Management or by a decree of a Court of Law and/or that the corner points mentioned in lines 3, 4 and 5 above were in conformance with the rules of the Michigan Board of Land Surveyors or by a Decree of a Court of Law; established, re-established, monumented, re-monumented, recovered, found as expressed below:

NOTE: Not more than 4 corners, all in the same town and range, may be recorded on this certificate.

A. Description of original monument and accessories and/or subsequent restoration:

1838 - S. Sibley, G.L.O.
#1 - 10" Pine N48°W 36 Links
#2 - 8" Pine S16°E 1.45

1933 - George Johnson, Co. Sur.
Began at Sec. Cor. of Sections 3, 4, 9 & 10, ran N89°W 5132' to cor. of Sections 4, 5, 8 & 9. Set 1/4 post and W.1/8 post. Witnesses to 1/4 post:
#3 - 12" B. Oak S60°E 33'
Witness to W.1/8 post:
10" B. Oak S23°E 10.5'

1972 - E.R. Benkert, LS 1237
"Large Wood Post set by U.S.F.S."
No accessory given, showed distance to Section cor. of 4, 5, 8 & 9 of 2649.60'

(See over for continuation of "A")

B. Description of corner evidence found and/or method applied in restoring or reestablishing corner:

F-3 - 1/4 Corner common to Section 4 & 9, T18N, R13W, Webber Twp., Lake Co., Mi.

I found U.S.F.S. Monument 60 feet more or less South of East and West dirt trail. I also found G. Johnson's W. 1/8 post 34.7 feet North and 1.25 feet West of true location. I found a U.S.F.S. location post 69 feet East of corner (apparently the one used by Benkert) measuring 2640 feet to the Southwest corner of Section 4.

Condition of accessories are as follows: #1 Gone, #2 Gone, #3 Gone, #4 Dead, #5 Found Stub, #6 Found in good condition, #7 Found Stump.

RATIFIED BY THE LAKE CO. PEER REVIEW GROUP
IN ACCORDANCE WITH P.A. 345
CHAIRMAN R.S.W.
DATE 11-12-96

C. Description of monument for corner and accessories established to perpetuate locating the position of the corner:


F-3 - 1/4 Corner common to Section 4 & 9, T18N, R13W, Webber Twp., Lake Co., Mi.

I accepted the U.S.F.S. Concrete Monument as a substantial marker for the corner, and is accepted as a careful and faithful re-establishment of the position of the original corner.

- 13" J. Pine N12°E 94.18' (nail & cap in W. side) #6
10" B. Oak S20°W 32.57' (60d spike in E. side)
12" B. Oak (Tri.) S79°E 46.33' (60d spike in S. side)
10" B. Oak N48°E 30.71' (60d spike in E. side)

Signed by Robert L. Wetherell Date 11-13-1996
24624

Surveyor's Michigan License No. 24624

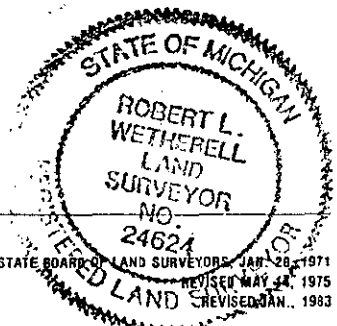

## CONTINUATION OF "A" - DESCRIPTION OF ORIGINAL MONUMENT AND ACCESSORIES AND/OR SUBSEQUENT RESTORATION:

1973 - Clinton E. Cole, LS 17615

Set Concrete monument by single proportionate method. (2570.21' respectively)

#4 - 10" B. Oak S36<sup>0</sup>W 34.72'

#5 - 8" B. Oak N50<sup>0</sup>W 44.46'

#6 - 12" J. Pine N12<sup>0</sup>E 94.18'

1974 - Robert A. Griffin, LS 13584

Set 5" x 60" U.S.F.S. Concrete Monument

#4 - 10" B. Oak S36<sup>0</sup>W 34.72'

#5 - 8" B. Oak N50<sup>0</sup>W 44.46'

#6 - 12" J. Pine N12<sup>0</sup>E 94.18'

1991 - Robert L. Wetherell, LS 24624

Survey recorded in Liber 003, Page 282

U.S.F.S. Concrete Monument

#6 - 12" J. Pine N12<sup>0</sup>E 94.18'

#5 - 9" B. Oak N50<sup>0</sup>W 44.46'

#7 - 15" B. Oak S10<sup>0</sup>E 62.05'