

MAY 16 1997
COMMISSION


LAND CORNER RECORDATION CERTIFICATE LIBER 003 PAGE 0393
Filing Requirement of Act 74, Mich. P.A. 1970

For corners in

Lake (County)	Located In:		Corner Code #
	18N	13W	
1. Public Land Survey	T	R	G-3
	T	R	
	T	R	
	T	R	
2. Property Controlling in Section	S	T	R
	S	T	R
3. Miscellaneous Property in Sec.	S	T	R
	S	T	R

RECORDED
LAKE COUNTY, MI.
NOV 14 11 26 AM '96
REGISTER OF DEEDS
Register of Deeds Stamp & File Number

4. Lot No. _____, Recorded Plat _____
5. Private Claims _____

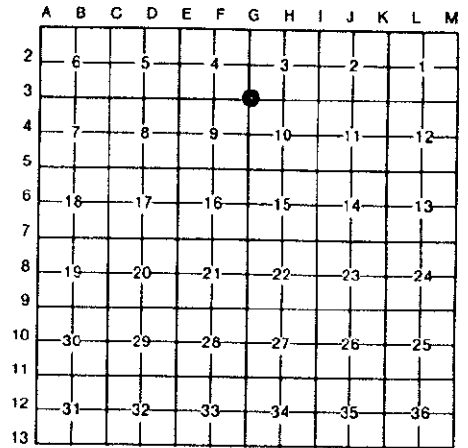

Robert L. Wetherell August 7, 1996

I, Robert L. Wetherell, in a field survey on August 7, 1996, do hereby certify that under requirements of P.A. 74, Michigan P.A. of 1970, the corner points mentioned in lines 1 and 2 above were in conformance with regulations and rules therefore as required in the current manual of survey instructions of the United States Department of the Interior, Bureau of Land Management or by a decree of a Court of Law and/or that the corner points mentioned in lines 3, 4 and 5 above were in conformance with the rules of the Michigan Board of Land Surveyors or by a Decree of a Court of Law; established, re-established, monumented, re-monumented, recovered, found as expressed below:

NOTE: Not more than 4 corners, all in the same town and range, may be recorded on this certificate.

A. Description of original monument and accessories and/or subsequent restoration:
G-3 - Corner common to sections 3, 4, 9 & 10, T18N, R13W, Webber Twp., Lake Co., Mi.

- | | | |
|-----------------------------------|---|-------------------------------------|
| 1838 - S. Sibley, G.L.O. | 1965 - Robert Griffin LS 13584 - L.C.R.C. - Liber 01, Page 74 | 1976 - Clinton E. Cole, LS 17615 |
| #1 - 7" Pine S18°W 12 Links | Found a 1/2" pipe and stump of Johnson's witness No. 3. Replaced with U.S.F.S. 5" x 60" Concrete Monument | U.S.F.S. Concrete Monument |
| #2 - 10" Pine S75°E 11 Links | | Same accessories as Griffins (1965) |
| Undated George Johnson (1915 m/L) | #4 - 6" W. Oak N71°E 14.74' | |
| #3 - 8" B. Oak North 47-1/2 Links | #5 - 5" W. Oak S14°E 110.39' | |
| | #6 - 5" W. Oak S26°W 97.69' | |
| | #7 - 7" W. Oak N24°W 70.34' | |
| | #8 - 6" x 7' Post North 1.5' | |

B. Description of corner evidence found and/or method applied in restoring or reestablishing corner:

G-3 - Corner common to Sections 3, 4, 9 & 10, T18N, R13W, Webber Twp., Lake Co., Mi.

I found the U.S.F.S. Concrete Monument 20 feet more or less North of dirt trail road.

Condition of the accessories are as follows: #1 gone, #2 Gone, #3 Gone, #4 Found in good condition, #5 Found in good condition, #6 Found in good condition, #7 Found in good condition, #8 Down.

RATIFIED BY THE LAKE CO. PEER REVIEW GROUP
IN ACCORDANCE WITH P.A. 345
CHAIRMAN R.L.W.
DATE 11-12-96



C. Description of monument for corner and accessories established to perpetuate locating the position of the corner:

G-3 - Corner common to Sections 3, 4, 9 & 10, T18N, R13W, Webber Twp., Lake Co., Mi.

I accepted the U.S.F.S. Concrete Monument as a substantial marker for the corner, and is accepted as a careful and faithful re-establishment of the position of the original corner.

- 12" W. Oak S58°E 46.80' (60d spike in S. side)
- 10" W. Oak N75°E 14.74' (dock spike in N. side) #4
- 8" W. Oak N20°W 70.34' (dock spike in N.E. side) #7
- 8" W. Oak S26°W 97.69' (dock spike in S.E. side) #6

Signed by Robert L. Wetherell Date 11-13-1996
Surveyor's Michigan License No. 24624

174