

NOV 21 1997

COMMISSION

LAND CORNER RECORDATION CERTIFICATE
Filing Requirement of Act 74, Mich. P.A. 1970


LIBER 004 PAGE 0074

RECORDED
LAKE COUNTY, MI.
OCT 29 2 59 PM '97
REGISTER OF DEEDS
Register of Deeds Stamp & File Number

For corners in

	(County)	Located In:		Corner Code #
		18N	13W	
1. Public Land Survey		T	R	I-9
		T	R	
		T	R	
		T	R	
2. Property Controlling in Section	S	T	R	
	S	T	R	
3. Miscellaneous Property in Sec.	S	T	R	
	S	T	R	

- 4. Lot No. _____, Recorded Plat _____
- 5. Private Claims _____

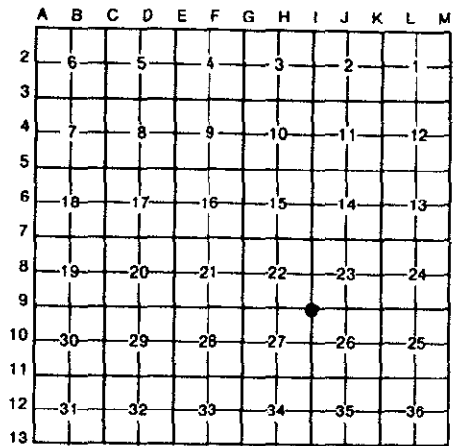

I, Robert L. Wetherell, in a field survey on October 10, 1997, do hereby certify that under requirements of P.A. 74, Michigan P.A. of 1970, the corner points mentioned in lines 1 and 2 above were in conformance with regulations and rules therefore as required in the current manual of survey instructions of the United States Department of the Interior, Bureau of Land Management or by a decree of a Court of Law and/or that the corner points mentioned in lines 3, 4 and 5 above were in conformance with the rules of the Michigan Board of Land Surveyors or by a Decree of a Court of Law; established, re-established, monumented, re-monumented, recovered, found as expressed below:

NOTE: Not more than 4 corners, all in the same town and range, may be recorded on this certificate.

A. Description of original monument and accessories and/or subsequent restoration:

I-9 - Section corner common to Sections 22, 23, 26 & 27, T18N, R13W, Lake Co., Mi.


- | | | |
|--|-------------------------------------|---|
| <u>1838 - S. Sibley, G.L.O.</u> | <u>1951 - George Blass, LS 5489</u> | <u>1990 - Clinton E. Cole, LS 17615</u> |
| #1 - 10" Pine N26°E 41 Links | "Found Concrete Post" | Concrete Monument |
| #2 - 12" Pine S54°W 22 Links | #5 - 10" B. Oak S24°E 88.0' | #7 - 9" Oak N38°W 43.50' |
| <u>1928 - George Johnson, Co. Sur.</u> | #6 - 8" W. Oak N26°E 58.65' | #6 - 12" Oak N30°E 58.81' |
| #3 - 12" B. Oak N16°30'E 79' | #7 - 6" W. Oak N40°W 43.40' | #5 - 12" Oak S24°E 88.25' |
| #4 - 12" B. Oak N6°30'W 70.5' | #8 - Anchor Pole N.W. 49.43' | |
| Developed plat of "Lakewoods Acres". | #9 - Power Pole S.W. 48.93' | |
| This being the N.E. corner of said plat. | | |

B. Description of corner evidence found and/or method applied in restoring or reestablishing corner:

I-9 - Section corner common to Sections 22, 23, 26 & 27, T18N, R13W, Lake Co., Mi.

I found a 4" x 4" Concrete Monument (with 1" pipe inside) in the intersection of roads North, South East and West. The concrete Monument is the type commonly used by George Johnson.

Condition of the accessories are as follows: #1 gone, #2 gone, #3 Gone, #4 Gone, #5 Found in good condition, #6 Gone, #7 Gone, #8 Found in good condition, #9 Found in good condition.

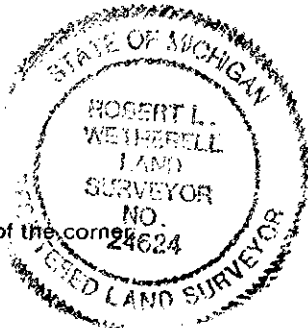

Description of monument for corner and accessories established to perpetuate locating the position of the corner:

I-9 - Section corner common to Sections 22, 23, 26 & 27, T18N, R13W, Lake Co., Mi.

I accepted the 4" x 4" Concrete Monument as a substantial marker for the corner, and is accepted as a careful and faithful re-establishment of the position of the original corner.

- 17" B. Oak S19°E 88.17' (60d spike in W. side) #5
- 7" W. Oak S44°W 102.71' (60d spike in E. side)
- 10" W. Oak N45°W 61.14' (60d spike in S.W. side)
- 14" W. Oak N84°E 110.21' (60d spike in N. side)

RATIFIED BY THE LAKE CO. PEER REVIEW GROUP
IN ACCORDANCE WITH P.A. 345
CHAIRMAN RJW
DATE 10.23-97

Signed by Robert L. Wetherell
24624

Date 10-28-97

Surveyor's Michigan License No. _____