SURVEY & REMONUMENTATION

NOV 21 1997

COMMISSION

LIBER 004 PAGE 0076

LAND CORNER RECORDATION CERTIFICATE

Filing Requirement of Act 74, Mich. P.A. 1970

For corners in Lake (County)

	Located In:		Corner Code ##
	18N	13W	K-9
1. Public Land Survey	T ____	R ____	
	T ____	R ____	
	T ____	R ____	
	T ____	R ____	
2. Property Controlling	S ____ T ____	R ____	
in Section	S ____ T ____	R ____	
3. Miscellaneous	S ____ T ____	R ____	
Property in Sec.	S ____ T ____	R ____	

RECORDED LAKE COUNTY, MI.
OCT 29 2 59 PM '97
Jeanine K. Richard
REGISTER OF DEEDS

Register of Deeds Stamp & File Number

4. Lot No. _____ , Recorded Plat _____
5. Private Claims _____

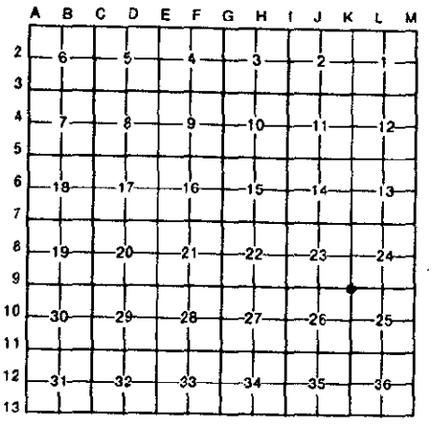

I, Robert L. Wetherell, in a field survey on October 10, 97, 19 _____, do hereby certify that under requirements of P.A. 74, Michigan P.A. of 1970, the corner points mentioned in lines 1 and 2 above were in conformance with regulations and rules therefore as required in the current manual of survey instructions of the United States Department of the Interior, Bureau of Land Management or by a decree of a Court of Law and/or that the corner points mentioned in lines 3, 4 and 5 above were in conformance with the rules of the Michigan Board of Land Surveyors or by a Decree of a Court of Law; established, re-established, monumented, re-monumented, recovered, found as expressed below:

NOTE: Not more than 4 corners, all in the same town and range, may be recorded on this certificate.

A. Description of original monument and accessories and/or subsequent restoration:

K-9 - Section corner common to Sections 23, 24, 25 & 26, T18N, R13W, Lake Co., Mi.

1838 - S. Sibley, G.L.O.
#1 - 6" Pine S54°E 18 Links
#2 - 6" Pine S45° 19 Links

1951 - George Blass, LS 5489
Found 3/4" Pipe
#3 - 14" B. Oak S29°W 54.4'
#4 - 14" B. Oak N60°W 44.0'
#5 - 10" W. Oak N54°E 40.8'

B. Description of corner evidence found and/or method applied in restoring or reestablishing corner:

K-9 - Section corner common to Sections 23, 24, 25 & 26, T18N, R13W, Lake Co., Mi.

I found a 3/4" pipe with a 1/2" rod in the center of the intersection of roads East, North and South. Corner is in line with fence to the West.

Condition of the accessories are as follows: #1 Gone, #2 gone, #3 Found stump #4 Found in good condition (tree is a W. Oak), #5 Found in good condition, (tree is a B. Oak).

STATE OF MICHIGAN
ROBERT L. WETHERELL
LAND SURVEYOR
NO. 24624
REGISTERED LAND SURVEYOR

C. Description of monument for corner and accessories established to perpetuate locating the position of the corner:

K-9 - Section corner common to Sections 23, 24, 25 & 26, T18N, R13W, Lake Co., Mi.

I replaced the 3/4" pipe with a 3/4" x 24" re-bar with Lake County Brass Cap, and is accepted as a careful and faithful re-establishment of the position of the original corner.

13" W. Oak N57°W 44.13' (60d spike in S. side) #4
15" B. Oak N59°E 41.24' (60d spike in N. side) #5
Power Pole S57°E 62.83' (P.K. Nail in N. side)
3" Galvanized Pipe (Fence corner post) West 32.93' (center of pipe)

RATIFIED BY THE LAKE CO. PEER REVIEW GROUP
IN ACCORDANCE WITH P.A. 345
CHAIRMAN RJW
DATE 10·23·97

Signed by Robert L. Wetherell Date 10-28-97

Surveyor's Michigan License No. 24624

FORM APPROVED BY MICHIGAN STATE BOARD OF LAND SURVEYORS, JAN. 28, 1971
REVISED MAY 14, 1975
REVISED JAN., 1983