

MAY 16 1957

COMMISSIONER

LAND CORNER RECORDATION CERTIFICATE
Filing Requirement of Act 74, Mich. P.A. 1970

LIBER 003 PAGE 0408

RECORDED
LAKE COUNTY, MI.
Dec 16 10 26 AM '96
REGISTER OF DEEDS

For corners in

Lake (County)	Located In:		Corner Code #
	18N	14W	
1. Public Land Survey	T	R	A-8
	T	R	
	T	R	
	T	R	
2. Property Controlling in Section	S	R	
	S	R	
3. Miscellaneous Property in Sec.	S	R	
	S	R	

Register of Deeds Stamp & File Number

4. Lot No. _____, Recorded Plat _____
5. Private Claims _____

I, Robert L. Wetherell, in a field survey on November 12, 1996, do hereby certify that under requirements of P.A. 74, Michigan P.A. of 1970, the corner points mentioned in lines 1 and 2 above were in conformance with regulations and rules therefore as required in the current manual of survey instructions of the United States Department of the Interior, Bureau of Land Management or by a decree of a Court of Law and/or that the corner points mentioned in lines 3, 4 and 5 above were in conformance with the rules of the Michigan Board of Land Surveyors or by a Decree of a Court of Law; established, re-established, monumented, re-monumented, recovered, found as expressed below:

	A	B	C	D	E	F	G	H	I	J	K	L	M
2	6	5	4	3	2	1							
3													
4	7	8	9	10	11	12							
5													
6	18	17	16	15	14	13							
7													
8	19	20	21	22	23	24							
9													
10	30	29	28	27	26	25							
11													
12	31	32	33	34	35	36							
13													

NOTE: Not more than 4 corners, all in the same town and range, may be recorded on this certificate.

A. Description of original monument and accessories and/or subsequent restoration.
A-8 - 1/4 Corner common to Section 19, T18N, R14W, Lake Co., Mi. and Section 24, T18N, R15W, Mason Co., Mi.

1837 - Mullett & Brookfield, G.L.O.
#1 - 18" W. Pine N37°W 23 Links
#2 - 16" W. Pine S53°W 24 Links

1911 - County Survey Record Book
R.R. Angle Iron
#3 - 27" Pine Stu N54-1/2°W 73 Links
#4 - 26" Pine Stump N20°E 115 Links

1951 - George Blass, LS 5489
Found 1-1/4" Pipe and Angle Iron Bar along side. Corner raised with Bed Rail.
#5 - P.Pole N49°W 43.53'
#6 - End Fence Post S84°W 42.63'

(SEE OVER FOR CONTINUATION OF "A")


B Description of corner evidence found and/or method applied in restoring or reestablishing corner:

A-8 - 1/4 Corner common to Section 19, T18N, R14W, Lake Co., Mi. and Section 24, T18N, R15W, Mason Co., Mi.

I found a 10" Dock Spike over 5" x 60" Concrete Monument at intersection of roads North, South and East.

Condition of the accessories are as follows: #1 gone, #2 gone, #3 Gone, #4 Gone, #5 Found New Pole, #6 Found down, #7 Found in good condition, #8 Found in band condition, #9 Found in good condition.

WITNESSED BY THE L.A.S. CO. P.T.E.R REVIEW GROUP
IN ACCORDANCE WITH P.A. 345
CHAIRMAN
DATE 12-12-96

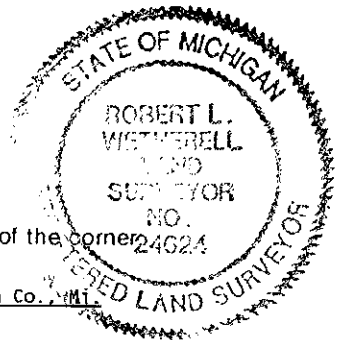

C. Description of monument for corner and accessories established to perpetuate locating the position of the corner

A-8 - 1/4 Corner common to Section 19, T18N, R14W, Lake Co., Mi. and Section 24, T18N, R15W, Mason Co., Mi.

I replaced the Dock Spike with a 3/4" x 8" re-bar and Lake County Brass Cap (directly over the 5" Concrete Monument), and is accepted as a careful and faithful re-establishment of the position of the original corner.

- P. Pole N47°W 42.98' (P.K. Nail in S.W. side)
- 10" W. Pine N40°E 72.6' (Center of Tree)
- 8" Tw. Elm S59°E 138.50' (60d spike in N. side)
- 6" B. Oak S43°W 92.14' (60d spike in N.W. side)
- 7" B. Oak S56°W 91.14' (60d spike in N.W. side)

Signed by Robert L. Wetherell Date 12-13-1996
24624

Surveyor's Michigan License No. _____

SURVEY &
REMONUMENTATION

MAY 16 1997

LIBER 003 PAGE 0409

COMMISSION

CONTINUATION OF "A" - DESCRIPTION OF ORIGINAL MONUMENT AND ACCESSORIES AND/OR SUBSEQUENT RESTORATION:

1971 - Robert Griffin, LS 13584

Replaced bed rail with 5" Concrete Monument

#7 - 5" W. Oak S70°E 212.37'

#8 - 3" R. Oak S20°E 163.57'

#5 - P. Pole N49°W 43.90'

#9 - 4" Post West 33.05'

1972 - Sammy Barnett, LS 16923

L.C.R.C. - Liber 02, Page 144.

Found Iron - Raised with Nail

#5 - P. Pole N49°W 43.90'

#9 - 4" x 4" Post West 33.05'

1975 & 1982 - Kenneth Ross, LS 17634

Monument by Griffin.

Reported a distance North of 2641.43' to

Section corner and South of 2646.5' to Section Corner.