

MAY 16 1997

LAND CORNER RECORDATION CERTIFICATE
Filing Requirement of Act 74, Mich. P.A. 1970

LIBER 003 PAGE 0413

For corners in

Lake (County)	Located In:		Corner Code #/
	18N	14W	
1. Public Land Survey	T _____	R _____	C-8
	T _____	R _____	
	T _____	R _____	
	T _____	R _____	
2. Property Controlling in Section	S _____	T _____ R _____	
	S _____	T _____ R _____	
3. Miscellaneous Property in Sec.	S _____	T _____ R _____	
	S _____	T _____ R _____	

REGISTER OF DEEDS
Shirley H. Adams
 DEC 16 10 27 AM '96
 REGISTERED
 LAKE COUNTY, MI.
 Register of Deeds Stamp & File Number

4. Lot No. _____, Recorded Plat _____
 5. Private Claims _____

	A	B	C	D	E	F	G	H	I	J	K	L	M
2	6		5		4		3		2		1		
3													
4	7		8		9		10		11		12		
5													
6	18		17		16		15		14		13		
7													
8	19		20		21		22		23		24		
9													
10	30		29		28		27		26		25		
11													
12	31		32		33		34		35		36		
13													

Robert L. Wetherell November 12, 1996

I, _____, in a field survey on _____, 19_____, do hereby certify that under requirements of P.A. 74, Michigan P.A. of 1970, the corner points mentioned in lines 1 and 2 above were in conformance with regulations and rules therefore as required in the current manual of survey instructions of the United States Department of the Interior, Bureau of Land Management or by a decree of a Court of Law and/or that the corner points mentioned in lines 3, 4 and 5 above were in conformance with the rules of the Michigan Board of Land Surveyors or by a Decree of a Court of Law; established, re-established, monumented, re-monumented, recovered, found as expressed below:

NOTE: Not more than 4 corners, all in the same town and range, may be recorded on this certificate.

A. Description of original monument and accessories and/or subsequent restoration:
C-8 - 1/4 Corner common to Sections 19 & 20, T18N, R14W, Lake Co., Mi.

1838 - S. Sibley, G.L.O.

#1 - 8" Cedar N37°W 9 Links

#2 - 6" Cedar S42°E 17 Links

1951 - George Blass - L.S. 5489

Found "U" shaped iron bar and remains of wood stake. Local resident, Mr. Stevenson, told him this had been used for at least 40 years. Raised with 1" pipe bed rail.

#3 - P. Pole N54°E 36.40'

#4 - N. Guy Anchor N23°E 69.95'

(SEE OVER FOR CONTINUATION OF "A")


B. Description of corner evidence found and/or method applied in restoring or reestablishing corner:

C-8 - 1/4 Corner common to Sections 19 & 20, T18N, R14W, Lake Co., Mi.

I found 5" x 60" U.S.F.S. Monument projecting 2.5 feet above the ground. I lowered the monument to 1.0 feet above the ground. Found pipe bed rail along side of monument.

Condition of the accessories are as follows: #1 Gone, #2 Gone, #3 Gone, #4 Found in good condition, #5 Found in good condition.

RATED BY _____
 DATE 12-12-96 *R.L.W.*

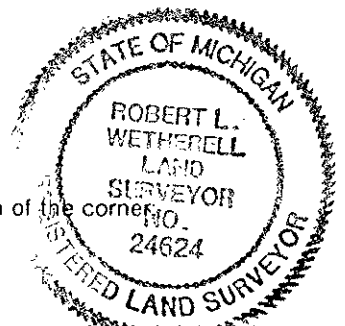

C. Description of monument for corner and accessories established to perpetuate locating the position of the corner:

C-8 - 1/4 Corner common to Sections 19 & 20, T18N, R14W, Lake Co., Mi.

I accepted the 5" x 60" Monument as a substantial marker for the corner, and is accepted as a careful and faithful re-establishment of the position of the original corner.

- 4" Post West 0.84'
- 2" Pipe Guy Anchor N30°E 70.08' (#4)
- P. Pole N46°E 74.12' (60d in S.E. side) New Pole
- 6" R. Pine S55°E 82.81' (60d in N.E. side)
- P. Pole S06°E 228.68' (60d in W. side)

Signed by *Robert L. Wetherell* Date *12-13-1996*

Surveyor's Michigan License No. 24624

MAY 1 8 1897

COMMISSION

LIBER 003 PAGE 0414

CONTINUATION OF "A" - DESCRIPTION OF ORIGINAL MONUMENT AND ACCESSORIES AND/OR SUBSEQUENT RESTORATION:

1964 - Robert Griffin, LS 13584

L.C.R.C. - Liber 01, Page 95

Found Bed Rail and replaced with

5" x 60" Concrete Monument

#5 - Fence Post N2°E 33.15'

#4 - 2" P. Pole Anchor N23°E 70.0'

#3 - P. Pole N45°E 36.54'

1972 - Sammy Barnett, PS 16923

L.C.R.C. - Liber 02, Page 144

Found Concrete Monument

#5 - Corner Fence Post N6°E 33.22'

#3 - P. Pole N55°E 36.60'