

MAY 16 1997

COMMISSION

LAND CORNER RECORDATION CERTIFICATE
Filing Requirement of Act 74, Mich. P.A. 1970

LIBER 003 PAGE 0412


For corners in

Table with columns: Lake (County), Located In: (18N, 14W), Corner Code # (C-9). Rows include Public Land Survey, Property Controlling in Section, and Miscellaneous Property in Sec.

RECORDED LAKE COUNTY, MI. Dec 16 10 26 AM '96 REGISTER OF DEEDS

Register of Deeds Stamp & File Number

4. Lot No. , Recorded Plat
5. Private Claims

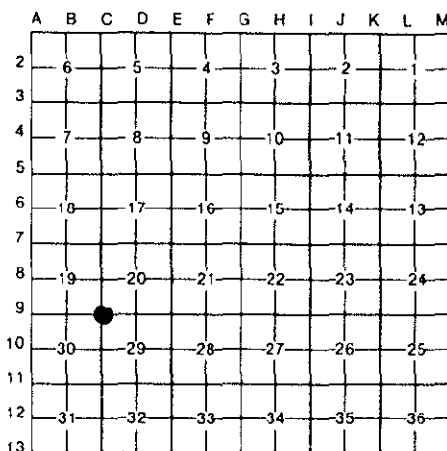

I, Robert L. Wetherell, in a field survey on November 12, 1996, do hereby certify that under requirements of P.A. 74, Michigan P.A. of 1970, the corner points mentioned in lines 1 and 2 above were in conformance with regulations and rules therefore as required in the current manual of survey instructions of the United States Department of the Interior, Bureau of Land Management or by a decree of a Court of Law and/or that the corner points mentioned in lines 3, 4 and 5 above were in conformance with the rules of the Michigan Board of Land Surveyors or by a Decree of a Court of Law; established, re-established, monumented, re-monumented, recovered, found as expressed below:

NOTE: Not more than 4 corners, all in the same town and range, may be recorded on this certificate.

A. Description of original monument and accessories and/or subsequent restoration.

C-9 - Section corner common to Sections 19, 20, 29 & 30, T18N, R14W, Lake Co., Mi.

Table with 3 columns: 1838 - S. Sibley, G.L.O. (36" Pine for corner), 1956 - George Blass, LS 5489 (Found 3/4" Iron Rod, #1-10" Elm, #2-14" W. Oak, #3-8" Cedar, #4-6" W. Oak), 1964 - Robert A. Griffin, LS 13584 (L.C.R.C. - Liber 01, Page 96, Did not recover Blass's rod. Reset from found witnesses. Set 5" x 36" Concrete Monument, #1-11" Tw. Elm, #3-9" Cedar, #4-9" W. Oak, #2-13" W. Oak, #5 - P. Pole).


B. Description of corner evidence found and/or method applied in restoring or reestablishing corner:

C-9 - Section corner common to Sections 19, 20, 29 & 30, T18N, R14W, Lake Co., Mi.

I located corner with magnetic locator. Corner is approximately 3 to 4 feet under newly constructed blacktop road. I did not dig up monument. I positioned corner with found accessories No. 2, No. 3 & No. 4.

Condition of the accessories are as follows: #1 gone, #2 found in good condition, #3 found in good condition, #4 found in good condition, #5 New Pole.

WITNESSED BY THE LAKE CO. DEED REVIEW GROUP IN ACCORDANCE WITH P.A. 345 CHAIRMAN DATE 12-12-96

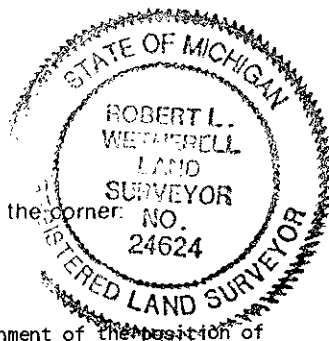

C. Description of monument for corner and accessories established to perpetuate locating the position of the corner:

C-9 - Section corner common to Sections 19, 20, 29 & 30, T18N, R14W, Lake Co., Mi.

I set a "Mag. Nail" over magnetic pull, and is accepted as a careful and faithful re-establishment of the position of the original corner.

- 14" W. Oak N35°W 57.86' (60d spike in N.E. side) #4
12" Cedar S60°W 132.25' (60d spike in E. side) #3
24" W. Oak S62°E 73.18' (60d spike in S. side) #2
12" R. Oak N82°E 65.88' (60d spike in N. side)

Signed by Robert L. Wetherell Date 12-13-1996
Surveyor's Michigan License No. 24624