

MAY 18 1997

LAND CORNER RECORDATION CERTIFICATE
Filing Requirement of Act 74, Mich. P.A. 1970

LIBER 003 PAGE 04 15

For corners in

Lake (County)	Located In:		Corner Code #
	18N	14W	
1. Public Land Survey	T ___ R ___	___	C-11
	T ___ R ___	___	___
	T ___ R ___	___	___
	T ___ R ___	___	___
2. Property Controlling in Section	S ___ T ___ R ___	___	___
	S ___ T ___ R ___	___	___
3. Miscellaneous Property in Sec.	S ___ T ___ R ___	___	___
	S ___ T ___ R ___	___	___

RECORDED
LAKE COUNTY, MI.
Dec 16 10 27 AM '96
REGISTER OF DEEDS
Shirley M. Bostad

Register of Deeds Stamp & File Number

4. Lot No. _____, Recorded Plat _____
5. Private Claims _____

	A	B	C	D	E	F	G	H	I	J	K	L	M
2	6	5	4	3	2								
3													
4	7	8	9	10	11	12							
5													
6	18	17	16	15	14	13							
7													
8	19	20	21	22	23	24							
9													
10	30	29	28	27	26	25							
11													
12	31	32	33	34	35	36							
13													

I, Robert L. Wetherell, in a field survey on September 7, 1996, do hereby certify that under requirements of P.A. 74, Michigan P.A. of 1970, the corner points mentioned in lines 1 and 2 above were in conformance with regulations and rules therefore as required in the current manual of survey instructions of the United States Department of the Interior, Bureau of Land Management or by a decree of a Court of Law and/or that the corner points mentioned in lines 3, 4 and 5 above were in conformance with the rules of the Michigan Board of Land Surveyors or by a Decree of a Court of Law; established, re-established, monumented, re-monumented, recovered, found as expressed below:

NOTE: Not more than 4 corners, all in the same town and range, may be recorded on this certificate.

A. Description of original monument and accessories and/or subsequent restoration:

C-11 - Section corner common to sections 29, 30, 31 & 32, T18N, R14W, Lake Co., Mi.


<u>1838 - S. Sibley G.L.O.</u>	<u>1951 - George Blass, LS 5489</u>	<u>1964 - Robert Griffin, LS 13584</u>
#1 - 8" Beech N38°E 45 Links	Found wood stake - replaced	Replaced 3/4" rod with 3 foot long square concrete monument
#2 - 6" W. Ash S77°W .3	with 3/4" rod.	L.C.R.C. Liber 01, Pg. 98.
<u>Undated - George Johnson, Co. Sur.</u>	#5 - 14" E. N47°W 36.50'	# 8 - 8" Maple S44°E 111.56'
#3 - 10" B. Oak S68°W 28'	#6 - 24" W. Pine S56°W 95.48'	# 7 - 14" W. Pine S29°W 106.89'
#4 - 10" W. Oak N55°E 59'	#7 - 8" W. Pine S29°W 106.52'	# 6 - 25" W. Pine S56°W 96.03'
(SEE OVER FOR CONTINUATION OF "A")		# 5 - 17" Elm N47°W 37.05'
		# 9 - 5" Maple N46°W 70.75'

B. Description of corner evidence found and/or method applied in restoring or reestablishing corner:

C-11 - Section corner common to Sections 29, 30, 31 & 32, T18N, R14W, Lake Co., Mi.

The pipe monument had been destroyed by recent road work by Lake County Road Commission. Set by using found accessories No. 6, No. 7, No. 8, No. 10 and No. 11. Accessories No. 1, 2, 3, 4, 5 & 9 were gone.

WATIFIED BY THE MICHIGAN BOARD OF LAND SURVEYORS
IN ACCORDANCE WITH P.A. 845
DATE 12-12-96

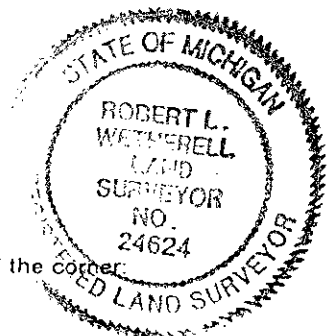

C. Description of monument for corner and accessories established to perpetuate locating the position of the corner:

C-11 - Section corner common to Sections 29, 30, 31 & 32, T18N, R14W, Lake Co., Mi.

I set a 3/4" x 24" re-bar with Lake County Brass Cap, and is accepted as a careful and faithful re-establishment of the position of the original corner.

- 10" Maple S44°E 111.56' (10" dock spike in S.W. side) #8
- 18" W. Pine S29°W 106.89' (60d spike in N.W. side) #7
- 8" R. Oak N65°E 101.25' (60d spike in N.W. side) #10
- 7" Maple N24°W 108.01' (60d spike in N.W. side) #11

Signed by Robert L. Wetherell Date 12-13-96

Surveyor's Michigan License No. 24624

SURVEY &
REMONUMENTATION

MAY 1 6 1997

COMMISSION

LIBER 003 PAGE 0416

CONTINUATION OF "A" - DESCRIPTION OF ORIGINAL MONUMENT AND ACCESSORIES AND/OR SUBSEQUENT RESTORATION:

1992 - Robert L. Wetherell, LS 24624

Found 5" Concrete Monument in poor condition.

Replaced with 3" pipe monument.

- # 8 - 12" Maple S44°E 111.56'
- # 7 - 21" W. Pine S29°W 106.89'
- # 6 - 31" W. Pine S56°W 96.03'
- #10 - 6" R. Oak N65°E 101.25'
- #11 - 6" Maple N24°W 108.01'