

**SURVEY & REMONUMENTATION**

**JAN 25 2001**

**LAND CORNER RECORDATION CERTIFICATE**

FILING REQUIREMENT OF ACT 74, Mich. P.A. 1970

**SECTION**

RECORDED  
LAKE COUNTY MI  
LIBER 004 PAGE 259

MAY 5 10 28 AM '00

*Whitney Myers*  
REGISTER OF DEEDS

Register of Deeds Stamp & File Number

For corners in Lake	Located in:	Corner Code#
1. Public Land Survey	T 18 N R 14 W	C-12
	T R	
	T R	
	T R	
2. Property Controlling in Section	S T R	
	S T R	
3. Miscellaneous Property in Sec.	S T R	
	S T R	
4. Lot No. _____ Recorded Plat _____		
5. Private Claims _____		

	A	B	C	D	E	F	G	H	I	J	K	L	M
1													
2	6	5	4	3	2	1							
3													
4	7	8	9	10	11	12							
5													
6	18	17	16	15	14	13							
7													
8	19	20	21	22	23	24							
9													
10	30	29	28	27	26	25							
11													
12	31	32	33	34	35	36							
13													

I, Robert L. Wetherell, in a field survey on March 10, 2000, do hereby certify that under requirements of P.A. 74, Michigan P.A. of 1970, the corner points mentioned in lines 1 and 2 above were in conformance with regulations and rules therefore as required in the current manual of survey instructions of the United States Department of the Interior, Bureau of Land Management or by decree of a Court of Law and/or that the corner points mentioned in lines 3, 4, and 5 above were in conformance with the rules of the Michigan Board of Land Surveyors or by a Decree Of a Court of Law, established, re-established, monumented, re-monumented, recovered, found as expressed below:

C-12 - 1/4 Corner common to Sections 31 & 32, T18N, R14W

**A. Description of original monument and accessories and/or subsequent restoration:**

1838 - S. Sibley, G.L.O.

- #1 - 10" Beech N54°W 13 Links
- #2 - 12" Beech S60°E 15 Links

1969 G. Blass, LS 5489

- Set "T" Iron by single proportionate method.
- #3 - Fence post N89°W 32.97'
- #4 - P. Pole S62°E 30.44'
- #5 - 8" Maple N60°E 77.88'
- #6 - Centerline road West 2.08'

1979 G. Bonney, LS 12016

- Survey recorded L. 02, Pg. 331
- #4 - P. Pole S70°E 30.48'
- #7 - T. Pole N65°W 34.9'
- #8 - 10" Pine N45°E 86.13'

**B. Description of corner evidence found and/or method applied in restoring or reestablishing corner:**

I found a "T" iron survey marker in line with fences East and West and 2 feet East of centerline of North and South road.


Condition of the accessories are as follows: #1 Gone, #2 Gone, #3 New Post, #4 Gone, #5 Found in good condition, #6 Measured 2 feet, #7 Gone, #8 Found in good condition.

**C. Description of monument for corner and accessories established to perpetuate locating the position of the corner:**

I replaced the "T" Iron with a 3/4" x 24" rebar the Lake County Remon Cap, and is accepted as a careful and faithful reestablishment of the position of the original corner.

- P. Pole S23°E 62.57' (mag nail N.E. side)
- 11" R. Oak S86°E 54.97' (60d spike N. side)
- 7" R. Pine S67°W 61.67' (60d spike S.E. side)
- 9" R. Pine N62°W 62.49' (60d spike S. side)

BATIFIED BY THE LAKE CO. DEED REVIEW GROUP  
IN ACCORDANCE WITH P.A. 345  
CHAIRMAN R.L.W.  
DATE 4-11-2000

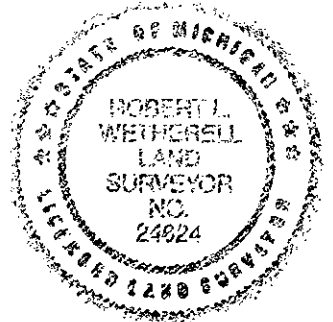

Signed by Robert L. Wetherell  
Surveyor's Michigan License No. 24624

Date April 12, 2000