

JAN 25 2001

LAND CORNER RECORDATION CERTIFICATE

FILING REQUIREMENT OF ACT 74, Mich. P.A. 1970

SECTION

RECORDED
LAKE COUNTY, MI.

LIBER 004 PAGE 0251

MAY 5 10 27 AM '00

Alley Myers
REGISTER OF DEEDS

Register of Deeds Stamp & File Number

For corners in Lake	Located in:	Corner Code#
1. Public Land Survey	T 18 N R 14 W	C-13
	T R	
	T R	
	T R	
2. Property Controlling in Section	S T R	
	S T R	
3. Miscellaneous Property in Sec.	S T R	
	S T R	
4. Lot No. _____ Recorded Plat _____		
5. Private Claims _____		

	A	B	C	D	E	F	G	H	I	J	K	L	M
1													
2	6	5	4	3	2	1							
3													
4	7	8	9	10	11	12							
5													
6	18	17	16	15	14	13							
7													
8	19	20	21	22	23	24							
9													
10	30	29	28	27	26	25							
11													
12	31	32	33	34	35	36							
13													

I, Robert L. Wetherell, in a field survey on March 10, 2000, do hereby certify that under requirements of P.A. 74, Michigan P.A. of 1970, the corner points mentioned in lines 1 and 2 above were in conformance with regulations and rules therefore as required in the current manual of survey instructions of the United States Department of the Interior, Bureau of Land Management or by decree of a Court of Law and/or that the corner points mentioned in lines 3, 4, and 5 above were in conformance with the rules of the Michigan Board of Land Surveyors or by a Decree Of a Court of Law; established, re-established, monumented, re-monumented, recovered, found as expressed below:

C-13 - Section corner common to Sections 31 & 32, T18N, R14W

A. Description of original monument and accessories and/or subsequent restoration:

1838 - Mullet & Brookfield, G.L.O.

- #1 - 12" Beech N62°E 17 Links
- #2 - 10" Hemlock N61°W 34 Links

1915 m/l - Charles Landon

- Unregistered Surveyor
- #3 - 32" W. Pine Stump N80°E 195 Links

Undated - Co. Sur. Records

- #4 - 10" B. Oak S67°W 47.5'
- #5 - 6" B. Oak N22°45'E 71.2'

1951 - G. Blass, LS 58489

- ¾" x 4' Pipe
- "Found rotted wood stake identified by near by resident".
- #6 - 10" Tw. B. Oak N24°W 68.10'
- #7 - 10" W. Pine S77°W 51.52'
- #8 - 24" Maple S76°E 83.75'

1964 - R.A. Griffin, 13584

- L.C.R.C. - L. 01, Pg. 99
- "Found ¾" Pipe".
- Replaced with 5" Conc. Mon.
- #9 - 12" R. Oak N38°E 122.45'
- #10 - Fence Post N49°E 39.05'
- #8 - 31" Maple S76°E 84.10'
- #7 - 14" W. Pine S77°W 52.00'
- #6 - 15" Tw. R. Oak N24°W 68.75'
- #11 - Anchor Pole S47°E 52.90'

B. Description of corner evidence found and/or method applied in restoring of reestablishing corner:

I found Griffin's 5" Concrete Monument 5 feet West of the centerline of a North and South road and in line with road to East and fence line to West.


Condition of the accessories are as follows: #1 gone, #2 Gone, #3 Gone, #4 Gone, #5 Gone, #6 Found in good condition, #7 Found in good condition, #8 Found dead, #9 Found in good condition, #10 Found leaning, #11 Found in good condition.

C. Description of monument for corner and accessories established to perpetuate locating the position of the corner:

I accepted the 5" Square Concrete Monument as a substantial marker for the corner, and is accepted as a careful and faithful reestablishment of the position of the original corner.

- 24" W. Pine S80°W 51.73' (60d spike N. side) #7
- 5" W. Pine N46°W 84.92' (60d spike s. side)
- Guy Pole N38°W 41.04' (60d spike N.E. side)
- 13" Ash S66°E 80.70' (60d spike S. side)
- Lake Co. Remon Iron (Corner common to Sections 5 & 6, T17N, R14W) - Due East 10.55'

VALIDATED BY THE LAKE CO. PEER REVIEW GROUP
IN ACCORDANCE WITH P.A. 345
CHAIRMAN *R.L.W.*
DATE 4-11-2000

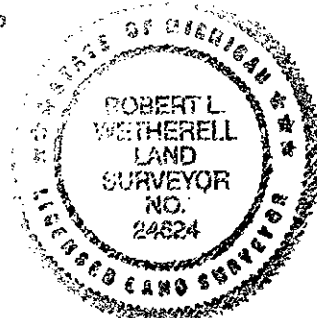

Signed by Robert L. Wetherell
Surveyor's Michigan License No. 24624

Date April 12, 2000