

SURVEY & REMONUMENTATION

JAN 14 1998

LAND CORNER RECORDATION CERTIFICATE
Filing Requirement of Act 74, Mich. P.A. 1970

For corners **SECTION**

Lake (County)	Located In:		Corner Code #
	18N	14W	
1. Public Land Survey	T _____	R _____	I-4
	T _____	R _____	
	T _____	R _____	
	T _____	R _____	
2. Property Controlling in Section	S _____	T _____	R _____
	S _____	T _____	R _____
3. Miscellaneous Property in Sec.	S _____	T _____	R _____
	S _____	T _____	R _____

4. Lot No. _____, Recorded Plat _____
 5. Private Claims _____

RECORDED
LAKE COUNTY, MI.
LIBER 004 PAGE 0092
DEC 12 11 38 AM '97


Richard H. Dickson
REGISTER OF DEEDS

Register of Deeds Stamp & File Number

Robert L. Wetherell, October 14, 1997

I, _____, in a field survey on _____, 19 _____, do hereby certify that under requirements of P.A. 74, Michigan P.A. of 1970, the corner points mentioned in lines 1 and 2 above were in conformance with regulations and rules therefore as required in the current manual of survey instructions of the United States Department of the Interior, Bureau of Land Management or by a decree of a Court of Law and/or that the corner points mentioned in lines 3, 4 and 5 above were in conformance with the rules of the Michigan Board of Land Surveyors or by a Decree of a Court of Law; established, re-established, monumented, re-monumented, recovered, found as expressed below:

NOTE: Not more than 4 corners, all in the same town and range, may be recorded on this certificate.

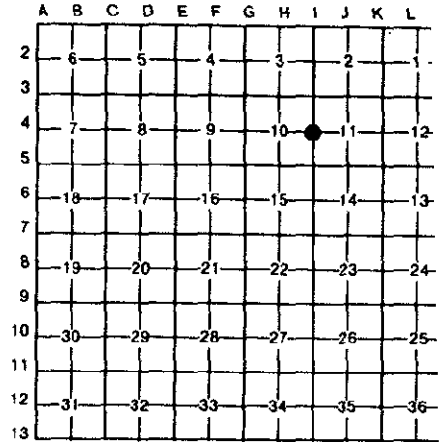

A. Description of original monument and accessories and/or subsequent restoration:

I-4 - 1/4 Corner common to Sections 10 & 11, T18N, R14W, Lake Co., Mi.

- 1838 - S. Sibley, G.L.O.
- #1 - 8" Pine N68°E 13 Links
- #2 - 6" Pine S32°W 86 Links

No subsequent restoration of record since G.L.O.

RATIFIED BY THE LAKE CO. PEER REVIEW GROUP
IN ACCORDANCE WITH P.A. 345
CHAIRMAN R. & W.
DATE 12-10-97

B. Description of corner evidence found and/or method applied in restoring or reestablishing corner:

I-4 - 1/4 Corner common to Sections 10 & 11, T18N, R14W, Lake Co., Mi.

I did not recover either of the Government witness trees. I found a 1-1/2" x 40" galvanized pipe extending out of the ground approximately 2 feet, and 30 feet West of the center of dirt road running North and South. I also found the same kind of 1-1/2" pipe at the approximate 1/16 corner South of the corner. I do not believe these pipes were the result of any survey, but rather a property owners attempt to establish their boundaries. I did not accept the found pipe for the corner. I set the corner at the intersection of line between Section corners and in line with old fence berm running West. This position falls 3 feet South of the found 1-1/2" pipe. I measured 2616.88 feet North to the Section corner and 2654.33 feet South to the Section corner.

C. Description of monument for corner and accessories established to perpetuate locating the position of the corner:

I-4 - 1/4 Corner common to Sections 10 & 11, T18N, R14W, Lake Co., Mi.

I set a 3/4" x 24" re-bar with Lake County Brass Cap, and is accepted as a careful and faithful re-establishment of the position of the original corner.

- 22" B. Oak N71°E 53.93' (60d spike in S. side)
- 10" B. Oak North 25.90 feet (60d spike in W. side)
- 10" B. Oak N88°W 83.60' (60d spike in N. side)
- 9" W. Oak S49°E 76.09' (60d spike in N.E. side)

Signed by Robert L. Wetherell

Date 12-12-97

Surveyor's Michigan License No. 24624

