

SURVEY & REMONUMENTATION

JAN 14 1998

SECTION

LAND CORNER RECORDATION CERTIFICATE
Filing Requirement of Act 74, Mich. P.A. 1970

RECORDED
LAKE COUNTY, MI.
LIBER 004 PAGE 0089

DEC 12 11 38 AM '97

Richard H. Richard

REGISTER OF DEEDS

Register of Deeds Stamp & File Number

For corners in

Lake (County)	Located In:		Corner Code #
	18N	14W	
1. Public Land Survey	T	R	I-5
	T	R	
	T	R	
	T	R	
2. Property Controlling in Section	S	T	R
	S	T	
3. Miscellaneous Property in Sec.	S	T	R
	S	T	

4. Lot No. _____, Recorded Plat _____
5. Private Claims _____

I, Robert L. Wetherell, in a field survey on October 14, 1997, do hereby certify that under requirements of P.A. 74, Michigan P.A. of 1970, the corner points mentioned in lines 1 and 2 above were in conformance with regulations and rules therefore as required in the current manual of survey instructions of the United States Department of the Interior, Bureau of Land Management or by a decree of a Court of Law and/or that the corner points mentioned in lines 3, 4 and 5 above were in conformance with the rules of the Michigan Board of Land Surveyors or by a Decree of a Court of Law; established, re-established, monumented, re-monumented, recovered, found as expressed below:

NOTE: Not more than 4 corners, all in the same town and range, may be recorded on this certificate.

A. Description of original monument and accessories and/or subsequent restoration:
I-5 - Section corner common to Sections 10, 11, 14 & 15, T18N, R14W, Lake Co., Mi.

- | | |
|---------------------------------|--|
| <u>1838 - S. Sibley, G.L.O.</u> | <u>Undated - Charles Landon</u> |
| #1 - 10" Pine N70°E 1.25 Chains | Unregistered Surveyor from Branch, Mi. |
| #2 - 10" Pine S69°W 1.2 Chains | #3 - 8" B. Oak N42°E 78 Links |
| | #4 - 8" W. Oak S20°E 34 Links |

1934 - Richard Minier - U.S.F.S. Tech.

- Found wood stake
#5 - 12" R. Oak N35°E 67-1/2 Links
#6 - 9" Oak N61°E 98-1/2 Links
#7 - 10" Oak S44-1/2°W 83 Links
#8 - 5" Oak S43°E 58 Links

(SEE OVER FOR CONTINUATION OF "A")

B. Description of corner evidence found and/or method applied in restoring or reestablishing corner:

I-5 - Section corner common to Sections 10, 11, 14 & 15, T18N, R14W, Lake Co., Mi.

I found the 5" x 36" Concrete Monument by Robert Griffin, 3 feet more or less West of the center of a dirt road running North and South.

Condition of the accessories are as follows: #1 Gone, #2 Gone, #3 Gone, #4 Gone, #5 Gone, #6 Found Stump, #7 Found in poor condition, #8 Found in good condition, #9 Found Stump, #10 Found in good condition, #11 Found in good condition, #12 Gone.

RATIFIED BY THE LAKE CO. PEER REVIEW GROUP
IN ACCORDANCE WITH P.A. 345
CHAIRMAN R.L.W.
DATE 12-10-97

C. Description of monument for corner and accessories established to perpetuate locating the position of the corner:

I-5 - Section corner common to Sections 10, 11, 14 & 15, T18N, R14W, Lake Co., Mi.



I accepted the 5" x 36" Concrete Monument as a substantial marker for the corner, and is accepted as a careful and faithful re-establishment of the position of the original corner.

- 9" W. Pine S67°W 73.55' (Dock Spike in N.W. side) #10
- 11" W. Oak N28°W 59.34' (Dock Spike in S.W. side) #11
- 6" W. Pine N53°E 75.00' (60d spike in S.E. side)
- 7" W. Pine S55°E 32.60' (60d spike in N.E. side)

Signed by Robert L. Wetherell

Date 12-12-97

Surveyor's Michigan License No. 24624

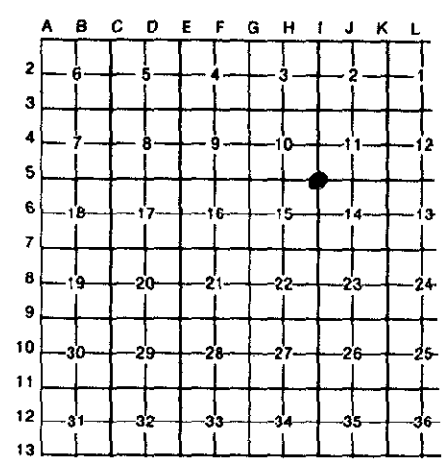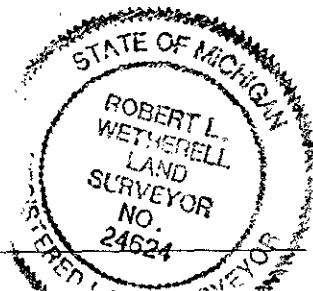

CONTINUATION OF "A" - DESCRIPTION OF ORIGINAL MONUMENT AND ACCESSORIES AND/OR SUBSEQUENT RESTORATION:

1953 - G. Blass, LS 5489

Found rotted wood stake from witnesses.

Set 1" x 24" Pipe

#6 - 10" Oak N61°E 65.01'

#7 - 12" Oak S44-1/2°W 55.70'

#8 - 8" Oak S43°E 38.28'

1964 - Robert A. Griffin, LS 13584

L.C.R.C. - Liber 01, Page 125

Found 1" x 24" Pipe and replaced with 5" x 36" Concrete Monument

#9 - 16" B. Oak N35°E 58.05'

#6 - 15" B. Oak N61°E 65.45'

#8 - 14" B. Oak S43° 38.55'

#7 - 15" B. Oak S44-1/2°W 55.90'

#10 - 4" W. Pine S62°W 73.55'

#11 - 7" W. Oak N31°W 59.19'

#12 - 6" x 7' Post West 33'

SURVEY &
REMONUMENTATION

JAN 14 1998

SECTION