

**SURVEY &
REMONUMENTATION**

AUG 31 1999

LAND CORNER RECORDATION CERTIFICATE

FILING REQUIREMENT OF ACT 74, Mich. P.A. 1970

SECTION

RECORDED
LAKE COUNTY, MI.
LIBER 004 PAGE 0215

JUL 23 3 06 PM '99

Christine H. Dickland
REGISTER OF DEEDS

For corners in Lake _____	Located in:	Corner Code#
1. Public Land Survey	T 18N R 14W	J-9
	T R	
	T R	
	T R	
2. Property Controlling in Section	S T R	
	S T R	
3. Miscellaneous Property in Sec.	S T R	
	S T R	
4. Lot No. _____ Recorded Plat _____		
5. Private Claims _____		

Register of Deeds Stamp & File Number

	A	B	C	D	E	F	G	H	I	J	K	L	M
1													
2	6	5	4	3	2	1							
3													
4	7	8	9	10	11	12							
5													
6	18	17	16	15	14	13							
7													
8	19	20	21	22	23	24							
9													
10	30	29	28	27	26	25							
11													
12	31	32	33	34	35	36							
13													

I, Robert L. Wetherell, in a field survey on January 25, 1999, do hereby certify that under requirements of P.A. 74, Michigan P.A. of 1970, the corner points mentioned in lines 1 and 2 above were in conformance with regulations and rules therefore as required in the current manual of survey instructions of the United States Department of the Interior, Bureau of Land Management or by decree of a Court of Law and/or that the corner points mentioned in lines 3, 4, and 5 above were in conformance with the rules of the Michigan Board of Land Surveyors or by a Decree of a Court of Law; established, re-established, monumented, re-monumented, recovered, found as expressed below:

J-9 - 1/4 Corner common to Sections 23 & 26, T18N, R14W

A. Description of original monument and accessories and/or subsequent restoration:

1838 - S. Sibley, G.L.O.
#1 - 8" Pine S55°E 6 Links
#2 - 8" Pine N45°W 8 Links

1905 - R. Hollister
Showed distance of 20 Chains 11 Links to 1/16 corner to West

1991 - R.L. Wetherell, LS 24624
L.C.R.C. - L. 03, Pg. 118
Set 1/2" Capped Iron by single proportionate method, 2710.57 feet respectively.
#3 - 17" W. Oak S49°W 15.20'
#4 - 15" B. Oak N58°E 20.5'
#5 - 8" B. Oak N21°E 43.00'
#6 - 10" W. Oak S14°E 87.24'

B. Description of corner evidence found and/or method applied in restoring or reestablishing corner:

I found the 1/2" re-bar I set in 1991. Corner is in a Red Pine plantation, 80 feet West of the East side and 60 feet North of the South side. I was unable to locate Hollister's 1/4 corner or W. 1/16 corner.


Condition of the accessories are as follows: #1 Gone, #2 Gone, #3 Found in good condition, #4 Found in good condition, #5 Found in good condition, #6 Found in good condition.

C. Description of monument for corner and accessories established to perpetuate locating the position of the corner:

I replace the 1/2" Capped Iron with a 3/4" x 24" re-bar with Lake County Remon Cap, and is accepted as a careful and faithful re-establishment of the position of the original corner.

- 20" W. Oak S49°W 15.20' (60d spike in S.E. side) #3
- 16" B. Oak N58°E 20.15' (60d spike in S.E. side) #4
- 9" B. Oak N21°E 43.00' (60d spike in W. side) #5
- 10" W. Oak S14°E 87.24' (60d spike in W. side) #6

RATIFIED BY THE LAKE CO. PEER REVIEW GROUP
IN ACCORDANCE WITH P.A. 345
CHAIRMAN *R&W*
DATE *7-20-99*

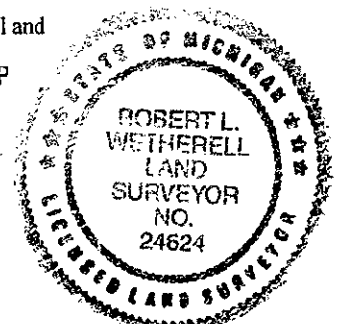

Signed by Robert L. Wetherell

Date July 21, 1999

Surveyor's Michigan License No. 24624