

SURVEY & REMONUMENTATION

AUG 31 1999

SECTION

LAND CORNER RECORDATION CERTIFICATE

FILING REQUIREMENT OF ACT 74, Mich. P.A. 1970

RECORDED
LAKE COUNTY MI
LIBER 004 PAGE 0213

For corners in
Lake _____

Located in: Corner Code#

JUL 23 3 06 PM '99

- 1. Public Land Survey T18N R 14W K-9
- 2. Property Controlling S T R in Section S T R
- 3. Miscellaneous S T R Property in Sec. S T R
- 4. Lot No. _____ Recorded Plat _____
- 5. Private Claims _____

REGISTER OF DEEDS

Register of Deeds Stamp & File Nu

I, Robert L. Wetherell, in a field survey on January 25, 1999, do hereby certify that under requirements of P.A. 74, Michigan P.A. of 1970, the corner points mentioned in lines 1 and 2 above were in conformance with regulations and rules therefore as required in the current manual of survey instructions of the United States Department of the Interior, Bureau of Land Management or by decree of a Court of Law and/or that the corner points mentioned in lines 3, 4, and 5 above were in conformance with the rules of the Michigan Board of Land Surveyors or by a Decree of a Court of Law; established, re-established, monumented, re-monumented, recovered, found as expressed below:

	A	B	C	D	E	F	G	H	I	J	K	L	M
1													
2	6	5	4	3	2	1							
3													
4	7	8	9	10	11	12							
5													
6	18	17	16	15	14	13							
7													
8	19	20	21	22	23	24							
9													
10	30	29	28	27	26	25							
11													
12	31	32	33	34	35	36							
13													

K-9 - Section corner common to Sections 23, 24, 25 & 26, T18N, R14W

A. Description of original monument and accessories and/or subsequent restoration:

1838 - S. Sibley, G.L.O.

- #1 - 12" Pine S73°E 11 Links
- #2 - 14" Pine N73°W 50 Links
- 1925 G. H. Johnson, Co. Sur.
- Iron Pipe

- #3 - 10" B. Oak S48°W 51'
- #4 - 11" B. Oak S21°E 83.5'

1963 - G. Blass, LS 5489

- "Located corner from old witnesses"
- Set 3/4" x 28" Iron Pipe, 15' East of trail road North and South.
- #5 - 12" B. Oak N25°E 19.98'
- #6 - 28" B. Oak S17°E 80.03' (O.B.T.)
- #7 - 18" B. Oak S55°W 61.33' (O.B.T.)

1964 - R.A. Griffin, LS 13584

- L.C.R.C. - L. 01, Pg. 136
- Found 1 1/4" Pipe
- Replaced with 5" Square Concrete Mon.
- Found stump hole with rotted remains of stump for accessory #2. Also found both of Johnson's accessories.
- #8 - 10" B. Oak N49°E 28.98'
- #9 - 3/4" Pipe N86°E 12.92'
- #4 - 19" B. Oak S21°E 83.78'
- #10 - 3" W. Pine S46°W 34.57'
- #3 - 17" B. Oak S48°30'W 51.30'
- #11 - 2" W. Pine N74°W 114.45'

1973 - Harry Kemitz, LS 16931

- Survey recorded in L. 01, Pg. 558-561
- Developed 12 parcels in the NW 1/4, Sec. 25, T18N, R14W.
- No accessories given.

1991 - R.L. Wetherell, LS 24624

- Used to Set S. 1/4 Cor. Sec. 23, T18N R14W
- Measured 2483.11 North to Sec. Cor.
- Measured 2710.57' West to 1/4 Cor. (Sct)

B. Description of corner evidence found and/or method applied in restoring of reestablishing corner:

I found Griffin's Concrete Monument in a North and South road. I measured East and found Kemitz Iron (1973) at a distance of 281.14' (he reported 281.85'). I also found Blass's Pipe (1963) S88°E 12.95' from this monument. I accepted Griffin's Monument and removed Blass's Pipe.


Condition of the accessories are as follows: #1 Gone, #2 Gone, #3 Found in good condition, #4 Found in good condition, #5 Found in good condition, #6 Found in good condition, #7 Found in good condition, #8 Found in good condition, #9 Found in good condition and removed.

C. Description of monument for corner and accessories established to perpetuate locating the position of the corner:

I accepted the 5" Concrete Monument as a substantial marker for the corner, and is accepted as a careful and faithful perpetuation of the position of the original corner.

- 7" W. Oak S76°E 81.98' (60d spike in S. side)
- 10" W. Pine N45°E 30.30' (60d spike in N.W. side)
- 24" B. Oak S51°W 51.29' (60d spike in S.E. Side) #3
- 11" B. Oak N54°E 29.03' (60d spike in S.E. side) #8
- 24" B. Oak S17°E 87.73' (60d spike in W. side) #4
- 8" W. Pine S49°W 34.51' (dock spike in S.E. side) #10
- 8" W. Pine N74°W 114.39' (dock spike in S. side) #11

RATIFIED BY THE LAKE CO. PEER REVIEW GROUP
IN ACCORDANCE WITH P.A. 345
CHAIRMAN R.L.W.
DATE 7-20-99

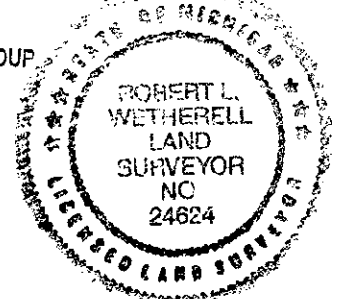

Signed by Robert L. Wetherell
Surveyor's Michigan License No. 24624

Date July 21, 1999