

LAND CORNER RECORDATION CERTIFICATE

FILING REQUIREMENT OF ACT 74, MICH. P.A.1970

FOR CORNERS OF--	LOCATED IN--	CORNER CODE NUMBER
1. PUBLIC LAND SURVEY	T. 19 N. R. 11 W.	G-1, G-2
2. PROPERTY CONTROLLING IN SECTION 3	T. 19 N. R. 11 W.	4
3. MISCELLANEOUS PROPERTY IN SECTION	T. N. R. W.	
4. LOT NO. RECORDED PLAT		
5. PRIVATE CLAIMS		

REGISTER OF DEEDS STAMP AND FILING NUMBER

I, CARL F. ROSER, do hereby certify that under requirements of P.A. 74, Michigan P.A. of 1970, the corner points mentioned in lines 1 and 2 above were, in a field survey on MARCH 7, 1984, established, re-established, monumented, re-monumented, recovered or restored as expressed below and in conformance with regulations and rules therefore as required in the current manual of survey instructions of the United States Department of the Interior, Bureau of Land Management or by a decree of a court of law. Furthermore, that the corner points mentioned in lines 3, 4 and 5 above were, in a field survey on 19, found, recovered, restored, established or re-established as expressed below and in conformance with the rules of the Michigan State Board of Registration for Land Surveyors or, by a Decree of a Court of Law:

A. Description of original monument and accessories and/or subsequent restoration:

- G-1 (CONT) F-1 (T19N R11W). C. COLE USED THIS FOR N 1/4 COR OF SEC 4 IN 1977. G.H.J. USED THIS FOR S 1/4 COR OF SEC 33 (PROBABLY 1929?) & APPARENTLY USED IT FOR N 1/4 COR OF SEC 4 ALSO.
- G-2 FD 1 1/4" PIPE THAT FITS 3 - CLINT COLE B.T. CORNER BELIEVED TO BE A RESULT OF G.H. JOHNSON'S SURVEYS IN SEC 3.
- 4 ESTAB NE COR OF SW 1/4 OF FRL NW 1/4 OF SEC 3 (CTR OF FRL NW 1/4 PER G.L.O. PLAT) PER STL B.L.M. INSTRUCTIONS. SEARCHED FOR G.H.J. IR. COULD NOT LOCATE. DID FIND AXE SHARPENED ROTTED OFF 2" X 2", S 62° 35' E, 10.3' IN N-S FN. REMAINS (DOWN).


B. Description of corner evidence found and/or method applied in restoring or re-establishing corner:

- G-1 FD OLD 1 1/2" RD IR ON W SIDE OF STONE IN APPROX CTR OF E-W GRAVEL RD. HAVE NO CHOICE BUT TO ACCEPT THIS AS COR COMM TO SEC'S 33 & 34 (T20N R11W) AND 3 & 4 (T19N R11W) FOR FOLLOWING REASONS: DECEASED CO. SURVEYOR'S NOTES, G.H. JOHNSON, SEC. 34, DATED 1918 CALL FOR RD IR ROD BY STONE FOR SW COR OF SEC. 34. WE ALSO FD STUMP OF G.H. JOHNSON'S SEC 34 B.T. ELM, S46°W, 32.8'. IN SEC 33, G.H. JOHNSON'S NOTES (DATE UNKNOWN) ALSO CALL FOR CTR OF BRIDGE, 323' WEST; WHICH FITS EXACTLY. G.H.J. ALSO SUBDIVIDED SEC 3, NW-NW, MAY 1935, USING THE SE OF SEC 33 ALSO AS THE NW OF SEC 3 (WE HAVE FD IR'S IN SEC 3 TO SUPPORT THIS). ALONG THE SAME LINE OF REASONING, WE FD AN OLD 1" PIPE AT OLD FN COR (FN'S E & S) FOR 1/4 COR COMM TO SEC'S 33 (T20N R11W) AND SEC 4 (T19N R11W), SEE COR CODE

C. Description of monument for corner and accessories established to perpetuate locating the position of the corner:

G-1	G-2	4
FD 1 1/2" RD IR ON W SIDE OF STONE; RAISED W/ 1 1/4" X 10" PIPE & RLS CAP.	FD 1 1/4" PIPE W/COUPLING; ADDED CED POST W/LOC TAG.	SET 5/8" X 34" REPOD W/RLS CAP & CED POST W/LOC TAG.
9" ASH N05°E 61.55	9" W PINE N45°W 115.20	12" CEDAR N05°E 17.9'
20" W PINE S70°E 86.52	9" W PINE N55°E 116.49	5" BL CHERRY N85°E 28.0'
CTR OLD BRDG OVER PINE RV WEST 323'	7" BL CHERRY S05°W 113.05	17" W PINE S50°W 38.1'
SET CED POST W/LOC TAG NORTH 33'	N-S WINDING SAND RD WEST 160'	10" CEDAR DUE W 13.8'
OLD FN COR (FN'S N10°E & S.)		

Carl F. Roser 6-19-84 DATE

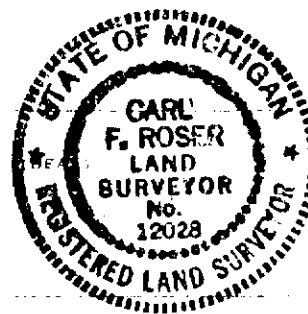

SURVEYOR'S MICHIGAN REGISTRATION NO. 12028

FOR STATE AND UNITED STATES AGENCIES:

SIGNED BY _____ DATE _____

CHIEF OF SURVEY PARTY

APPROVED AND SIGNED BY _____ DATE _____

MICHIGAN REGISTERED LAND SURVEYOR

(SEAL)

SURVEYOR'S MICHIGAN REGISTRATION NO.

ELI SWORTH TWP.
