

NOV 21 1997

COMMISSIONER

LAND CORNER RECORDATION CERTIFICATE  
Filing Requirement of Act 74, Mich. P.A. 1970

RECORDED  
LAKE COUNTY, MI.  
LIBER 004 PAGE 0047  
SEP 12 10 32 AM '97

For corners in  
Lake \_\_\_\_\_  
(County)

Located In: Corner Code #  
19N 11W B-11

- 1. Public Land Survey  
T \_\_\_\_\_ R \_\_\_\_\_  
T \_\_\_\_\_ R \_\_\_\_\_  
T \_\_\_\_\_ R \_\_\_\_\_  
T \_\_\_\_\_ R \_\_\_\_\_
- 2. Property Controlling  
in Section S \_\_\_\_\_ T \_\_\_\_\_ R \_\_\_\_\_  
S \_\_\_\_\_ T \_\_\_\_\_ R \_\_\_\_\_
- 3. Miscellaneous  
Property in Sec. S \_\_\_\_\_ T \_\_\_\_\_ R \_\_\_\_\_  
S \_\_\_\_\_ T \_\_\_\_\_ R \_\_\_\_\_

*Janet M. Schaub*  
REGISTER OF DEEDS

Register of Deeds Stamp & File Number

- 4. Lot No. \_\_\_\_\_, Recorded Plat \_\_\_\_\_
- 5. Private Claims \_\_\_\_\_

	A	B	C	D	E	F	G	H	I	J	K	L	M
2	6	5	4	3	2	1							
3													
4	7	8	9	10	11	12							
5													
6	18	17	16	15	14	13							
7													
8	19	20	21	22	23	24							
9													
10	30	29	28	27	26	25							
11	●												
12	31	32	33	34	35	36							
13													

Robert L. Wetherell February 24, 1997

I, \_\_\_\_\_, in a field survey on \_\_\_\_\_, 19\_\_\_\_\_, do hereby certify that under requirements of P.A. 74, Michigan P.A. of 1970, the corner points mentioned in lines 1 and 2 above were in conformance with regulations and rules therefore as required in the current manual of survey instructions of the United States Department of the Interior, Bureau of Land Management or by a decree of a Court of Law and/or that the corner points mentioned in lines 3, 4 and 5 above were in conformance with the rules of the Michigan Board of Land Surveyors or by a Decree of a Court of Law; established, re-established, monumented, re-monumented, recovered, found as expressed below:

NOTE: Not more than 4 corners, all in the same town and range, may be recorded on this certificate.

A. Description of original monument and accessories and/or subsequent restoration:

B-11 - 1/4 Corner common to Sections 30 & 31, T19N, R11W, Lake Co., Mi.

1838 - S. Sibley, G.L.O.

#1 - 24" Pine S2°E 18 Links

#2 - 10" Beech N15°E 13 Links

1907 - J. W. Nicholson, Co. Sur.

Found Original 1/4 Post

#3 - W. Pine Stump S13°E 22 Links

1976 - C. Roser, D.N.R., LS 12028

L.C.R.C. - Liber 02, Pg. 298

Set 5" x 48" Concrete Monument on line between Sec. Corners to E. & W. at prorated distance to G.L.O. Survey.

#4 - 7" W. Pine S55°E 69.1'

#5 - 10" W. Pine S60°W 60.0'

B. Description of corner evidence found and/or method applied in restoring or reestablishing corner:

B-11 - 1/4 Corner common to Sections 30 & 31, T19N, R11W, Lake Co., Mi.

I found the 5" Square Concrete Monument on East edge of swamp and in centerline of old road bed to the East.

Condition of the accessories are as follows: #1 Gone, #2 gone, #3 Gone, 4 Found in good condition, # 5 Found dead.

RATIFIED BY THE LAKE CO. PEER REVIEW GROUP  
IN ACCORDANCE WITH P.A. 345


CHAIRMAN *R.L.W.*  
DATE *8-27-97*

Description of monument for corner and accessories established to perpetuate locating the position of the corner:

B-11 - 1/4 Corner common to Sections 30 & 31, T19N, R11W, Lake Co., Mi.

I accepted the 5" Square Concrete Monument as a substantial marker for the corner, and is accepted as a careful and faithful re-establishment of the position of the original corner.

- 14" Maple N26°E 40.48' (60d spike in W. side)
- 12" W. Pine S52°E 69.74' (60d spike in S.W. side) #4
- 13" Maple S25°E 40.57' (60d spike in W. side)
- 7" Maple S89°W 8.30' (60d spike in S. side)
- 4" W. Pine S80°E 65.62' (60d spike in S. side)

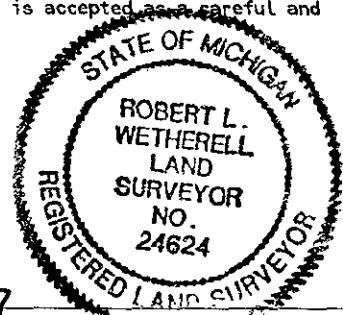

Witnessed by *Robert L. Wetherell*  
24624

Date *8-27-97*

Surveyor's Michigan License No. \_\_\_\_\_