

JAN 12 1996

COMMISSION

LAND CORNER RECORDATION CERTIFICATE  
Filing Requirement of Act 74, Mich. P.A. 1970

LIBER 003 PAGE 0318  
SEP 5 3 06 PM '95  
REGISTER OF DEEDS  
RECORDED  
LAKE COUNTY, MI.

For corners in

Lake (County)	Located In:		Corner Code #
	19N	11W	
A. Public Land Survey	T _____ R _____	_____	C-2
	T _____ R _____	_____	
	T _____ R _____	_____	
	T _____ R _____	_____	
B. Property Controlling in Section	S _____ T _____ R _____	_____	
	S _____ T _____ R _____	_____	
C. Miscellaneous Property in Sec.	S _____ T _____ R _____	_____	
	S _____ T _____ R _____	_____	


Register of Deeds Stamp & File Number

Lot No. \_\_\_\_\_, Recorded Plat \_\_\_\_\_  
Private Claims \_\_\_\_\_

Robert L. Wetherell May 11, 1995

I hereby certify that under requirements of P.A. 74, Michigan P.A. of 1970, the corner points mentioned in lines 1 and 2 above were in conformance with regulations and rules therefore as required in the current manual of survey instructions of the United States Department of the Interior, Bureau of Land Management or by a decree of a Court of Law and/or that the corner points mentioned in lines 3, 4 and 5 above were in conformance with the rules of the Michigan Board of Land Surveyors or by a Decree of a Court of Law, established, re-established, monumented, re-monumented, recovered, found as expressed below:

NOTE: Not more than 4 corners, all in the same town and range, may be recorded on this certificate.

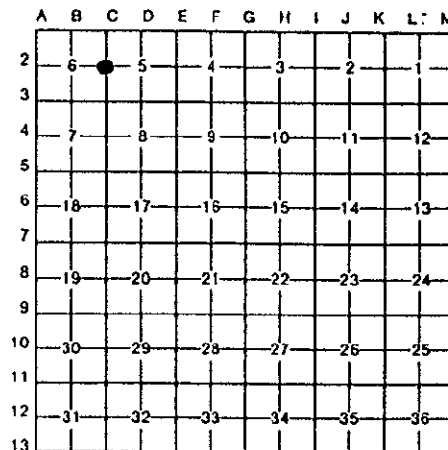

Description of original monument and accessories and/or subsequent restoration:

C-2 - 1/4 corner common to Sections 5 & 6, T19N, R11W, Ellsworth Township, Lake Co., Mi.

1838 - S. Sibley, G.L.O.

- #1 - 10" Beech S17°E 31 Links
- #2 - 6" Hemlock N49°E 17 Links

1978 - Gerald Gray, L.S. 17741

- Set iron rod
- #4 - 10" Poplar AZ 90° 26.96'
- #5 - 12" Poplar AZ 15° 89.55'
- #6 - 3" Pine AZ 350° 76.30'

1987 - Clinton E. Cole, LS 1761

Used Gray's iron and measured 2561.77' to the N.E. corner of Sec. 6 and 2650.67' to the S.E. corner of Sec. 6

1906 - John Nicholson, County Surveyor

- Established corner by measurement and survey
- #3 - 36" W. Pine Stump S42°W 107 Links

Description of corner evidence found and/or method applied in restoring or reestablishing corner:

C-2 - 1/4 corner common to Sections 5 & 6, T19N, R11W, Ellsworth Township, Lake Co., Mi.


I found a 1/2" re-bar in line with old fence to the East and in the approximate center of old abandoned road with right of way fences running North. Nicholson's 1906 corner was probably destroyed by road construction and his accessory (#3) destroyed by farm tilling. This position fits well with a fence intersection at the Center 1/4 of Section 6, (as established by Clinton Cole in 1987). I found all of surveyor Gray's accessories and measured 2561.12' to the Northeast corner of Section 6. Accessories 1, 2 and 3 were not recovered.

Description of monument for corner and accessories established to perpetuate locating the position of the corner:

C-2 - 1/4 corner common to Sections 5 & 6, T19N, R11W, Ellsworth Township, Lake Co., Mi.

I replaced the 1/2" re-bar with a 3/4" x 24" re-bar with Lake County Brass Cap, and is accepted as a careful and faithful re-establishment of the position of the original corner.

- 12" Poplar S84°E 27.02' (60d spike in N. Side) O.B.T. #4
- 7" W. Pine N59°E 46.10' (60d spike in S.E. side)
- 5" W. Pine N31°E 80.63' (60d spike in E. side)
- 12" W. Pine N7°W 73.35' (60d spike in W. side) O.B.T. #6

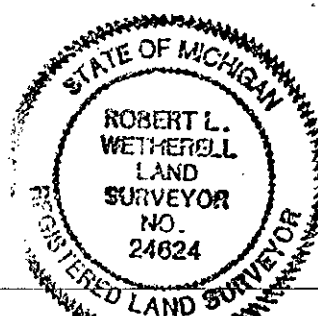

Signed by Robert L. Wetherell Date August 29, 1995  
24624

Surveyor's Michigan License No. \_\_\_\_\_  
RATIFIED BY THE LAKE CO. PEER REVIEW GROUP  
IN ACCORDANCE WITH P.A. 345  
CHAIRMAN R.W.  
DATE 8-29-95