

JAN 12 1996

COMMISSION

LAKE COUNTY REMONUMENTATION  
LAND CORNER RECORDATION CERTIFICATE  
Filing Requirement of Act 74, Mich. P.A. 1970

LIBER 003 PAGE 0314

REGISTER OF DEEDS  
*Shirley M. Brown*

SEP 5 3 05 PM '95

RECORDED  
LAKE COUNTY, MI.

or corners in

Lake (County)	Located In:		Corner Code #
	19N	11W	
Public Land Survey	T _____ R _____	C-7	_____
	T _____ R _____		_____
	T _____ R _____		_____
	T _____ R _____		_____
Property Controlling in Section	S _____ T _____ R _____		_____
	S _____ T _____ R _____		_____
Miscellaneous Property in Sec.	S _____ T _____ R _____		_____
	S _____ T _____ R _____		_____

Register of Deeds Stamp & File Number

Lot No. \_\_\_\_\_, Recorded Plat \_\_\_\_\_  
Private Claims \_\_\_\_\_

Robert L. Wetherell March 1, 1995

in a field survey on \_\_\_\_\_, 19\_\_\_\_\_,  
I hereby certify that under requirements of P.A. 74, Michigan P.A. of 1970, the corner points mentioned  
in lines 1 and 2 above were in conformance with regulations and rules therefore as required in the  
current manual of survey instructions of the United States Department of the Interior, Bureau of Land  
Management or by a decree of a Court of Law and/or that the corner points mentioned in lines 3, 4 and 5  
above were in conformance with the rules of the Michigan Board of Land Surveyors or by a Decree of a  
Court of Law; established, re-established, monumented, re-monumented, recovered, found as  
expressed below:

NOTE: Not more than 4 corners, all in the same town and range, may be recorded  
on this certificate.

Description of original monument and accessories and/or subsequent restoration:

C-7 - Section corner common to Sections 17, 18, 19 & 20, T19N, R11W, Lake Co., Mi.

1838 - S. Sibley, G.L.O.

#1 - 20" Hemlock S30°E 41 Links

#2 - 14" Pine N35°W 25 Links

Undated - George Johnson, Co. Sur.

#3 - 22" P. Stump S38°W 46'

1959 - M.S.H.D.

Axle Shaft

#4 - Fence Post S55°E 46.56'

#5 - P. Pole S65°E 59.02'

#6 - T. Pole N10°W 31.35'


(SEE OVER FOR CONTINUATION OF "A")

Description of corner evidence found and/or method applied in restoring or reestablishing corner:

C-7 - Section corner common to Sections 17, 18, 19 & 20, T19N, R11W, Lake Co., Mi.

I found 1-1/4" x 2-1/2" Axle Shaft. Which checked well with found accessories No. 5, 7, 8, 10 11 and 12. Accessories  
No. 1, 2, 3, 4 and 6 were gone.

RATIFIED BY THE LAKE CO. PEER REVIEW GROUP  
IN ACCORDANCE WITH P.A. 345  
CHAIRMAN *R.L.W.*  
DATE *8-29-95*

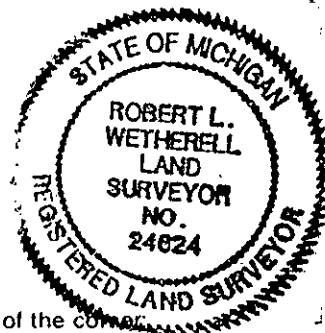

Description of monument for corner and accessories established to perpetuate locating the position of the corner:

C-7 - Section corner common to Sections 17, 18, 19 & 20, T19N, R11W, Lake Co., Mi.

I replaced the axle shaft with a 3/4" x 24" re-bar with Lake County Brass Cap, and is accepted as a careful and  
faithful re-establishment of the position of the original corner.

12" R. Pine N3°E 55.43' (#10) (60d spike in E. side)

2" B. Oak N45°W 45.7' (#12) (Center of tree)

P. Pole S54°E 58.70' (#5) (Found nail in N.E. side)

12" R. Pine S25°E 203.52' (60d spike in E. side)

Signed by *Robert L. Wetherell* Date August 29, 1995  
24624

Surveyor's Michigan License No. \_\_\_\_\_

SURVEY &  
REMONUMENTATION

JAN 1 2 1996

COMMISSION

LIBER 003 PAGE 0315

CONTINUATION OF "A" - DESCRIPTION OF ORIGINAL MONUMENT AND ACCESSORIES AND/OR SUBSEQUENT RESTORATION:

1972 - Clinton E. Cole, L.S. 17615

Survey recorded in Liber 01, Page 172

#5 - P. Pole S65°E 59.02'

#7 - P. Pole N60°E 119.60'

#8 - 8" R. Pine N30°W 61.72'

1994 - M. McClung, L.S. 13037

L.C.R.C. Liber 03, Page 22

#10 - 10" W. Pine North 55.6'

#5 - P. Pole 65°E 58.72'

#11 - Guard Post N60°W 8.65'

#12 - 2" Oak N60°W 45.7'