

REMONUMENTATION

NOV 21 1997

COMMISSION

RECORDED LAKE COUNTY, MI.

LIBER 004 PAGE 0046 SEP 12 10 32 AM '97

LAND CORNER RECORDATION CERTIFICATE Filing Requirement of Act 74, Mich. P.A. 1970

REGISTER OF DEEDS

For corners in

Table with columns: Lake (County), Located In: (19N, 11W), Corner Code (C-9). Rows include Public Land Survey, Property Controlling in Section, and Miscellaneous Property in Sec.

4. Lot No. , Recorded Plat
5. Private Claims

Register of Deeds Stamp & File Number

Grid table with columns A-M and rows 2-13. A dot is marked at the intersection of column C and row 9.

I, Robert L. Wetherell, in a field survey on March 10, 1997, do hereby certify that under requirements of P.A. 74, Michigan P.A. of 1970, the corner points mentioned in lines 1 and 2 above were in conformance with regulations and rules therefore as required in the current manual of survey instructions of the United States Department of the Interior, Bureau of Land Management or by a decree of a Court of Law and/or that the corner points mentioned in lines 3, 4 and 5 above were in conformance with the rules of the Michigan Board of Land Surveyors or by a Decree of a Court of Law; established, re-established, monumented, re-monumented, recovered, found as expressed below:

NOTE: Not more than 4 corners, all in the same town and range, may be recorded on this certificate.

A. Description of original monument and accessories and/or subsequent restoration:

- 1839 - S. Sibley, G.L.O. #1 - 16" Hemlock N40°W 40 Links #2 - 8" Beech S43°E 12 Links 1907 - J.W. Nicholson, Co. Sur. Subdivided Sec. 30, found original witness tree (down) #3 - 15" Hemlock N40°W 46 Links 1996 - Robert L. Wetherell, LS 24624 L.C.R.C. - Liber 003, Pg. 344. - 1/2" Capped Iron Rod Set this corner in line with fences N. & S. by doubling over a distance measured from the E.1/4 cor. to a fence line at the N.1/16 line. The distance from the E.1/4 cor. to the established N.E. cor. fit the 1907 Nicholson survey by 5'. I found remains of an old fence post at this location. Cor. falls on N. edge of E. & W. two track road. #7 - 12" Triple Beech N21°E 72.80' - #5 - 30" R. Oak S64°W 65.13' #4 - 12" Maple N18°W 52.35' - #6 - 6" Maple S45°E 88.94'

B. Description of corner evidence found and/or method applied in restoring or reestablishing corner:

C-9 - Sec. Cor. common to Sections 19, 20, 29 & 30, T19N, R11W, Lake Co., Mi.

I found the 1/2" Capped Iron I set in 1996. Condition of the accessories are as follows: #1 Gone, #2 Gone, #3 Found down, #4 Found in good condition, #5 Found in good condition, #6 Found in good condition, #7 Found in good condition.


RATIFIED BY THE LAKE CO. PEER REVIEW GROUP IN ACCORDANCE WITH P.A. 345 CHAIRMAN R.L.W. DATE 8-27-97

C. Description of monument for corner and accessories established to perpetuate locating the position of the corner:

C-9 - Sec. Cor. common to Sections 19, 20, 29 & 30, T19N, R11W, Lake Co., Mi.

I replaced the 1/2" Capped Iron with a 3/4" x 24" Re-bar with Lake County Brass Cap, and is accepted as a careful and faithful re-establishment of the position of the original corner.

- 12" Triple Beech N21°E 72.80' #7 12" Maple N18°W 52.35' #4 30" R. Oak S64°W 65.13' #5 6" Maple S45°E 88.94' #6

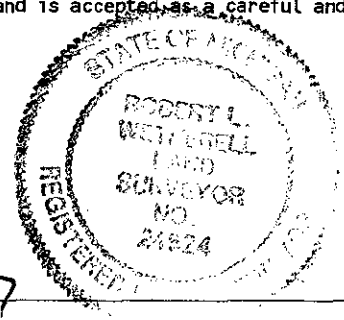

igned by Robert L. Wetherell 24624

Date 8-27-97

urveyor's Michigan License No.