

NOV 21 1997

COMMISSION

LIBER004 PAGE0077

LAND CORNER RECORDATION CERTIFICATE
Filing Requirement of Act 74, Mich. P.A. 1970

For corners in

Table with columns: Lake (County), Located In: (19N, 11W), Corner Code # (C-11). Rows include Public Land Survey, Property Controlling in Section, Miscellaneous Property in Sec.

REGISTER OF DEEDS
RECORDED
OCT 29 2 59 PM '97
LAKE COUNTY, MI.

Register of Deeds Stamp & File Number

4. Lot No. Recorded Plat
5. Private Claims

Grid table with columns A-M and rows 2-13. A dot is marked at row 11, column C.

Robert L. Wetherell February 24, 1997

I, in a field survey on do hereby certify that under requirements of P.A. 74, Michigan P.A. of 1970, the corner points mentioned in lines 1 and 2 above were in conformance with regulations and rules therefore as required in the current manual of survey instructions of the United States Department of the Interior, Bureau of Land Management or by a decree of a Court of Law and/or that the corner points mentioned in lines 3, 4 and 5 above were in conformance with the rules of the Michigan Board of Land Surveyors or by a Decree of a Court of Law; established, re-established, monumented, re-monumented, recovered, found as expressed below:

NOTE: Not more than 4 corners, all in the same town and range, may be recorded on this certificate.

A. Description of original monument and accessories and/or subsequent restoration:

C-11 - Section corner common to Sections 29, 30, 31 & 32, T19N, R11W, Lake Co., Mi.

1838 - S. Sibley, G.L.O.

#1 - 8" Maple S39°W 11 Links

#2 - 8" Maple N39°E 42 Links

1907 - J.W. Nicholson, Co. Sur.

#3 - W. Pine N43°E 61 Links

#4 - 8" cherry S32°W 31-1/2 Links

1976 - Carl Roser, D.N.R.

L.C.R.C. - Liber 02, Page 297

"Found 1/2" Pinch Pipe - Fits two of Ed Benkerts witnesses".

Set D.N.R. Monument

#5 - 4" W. Pine N75°W 65.1'

#6 - 5" W. Pine S60°W 28.8'

B. Description of corner evidence found and/or method applied in restoring or reestablishing corner:

C-11 - Section corner common to Sections 29, 30, 31 & 32, T19N, R11W, Lake Co., Mi.

I found a 1-1/2" Pipe capped with D.N.R. Aluminum Disk. Corner is 50 feet North of East and West Road.

Condition of the accessories are as follows: #1 gone, #2 gone, #3 Gone, #4 Gone, #5 Found in good condition, #6 Gone.

RATIFIED BY THE LAKE CO. PEER REVIEW GROUP
IN ACCORDANCE WITH P.A. 345
CHAIRMAN
DATE 10-23-97

C. Description of monument for corner and accessories established to perpetuate locating the position of the corner:

C-11 - Section corner common to Sections 29, 30, 31 & 32, T19N, R11W, Lake Co., Mi.

I accepted the D.N.R. Monument as a substantial marker for the corner, and is accepted as a careful and faithful re-establishment of the position of the original corner.


8" W. Oak S40W 90.50' (60d spike in W. side)

13" W. Pine N75°W 65.43' (60d spike in S. side) #5

9" W. Oak N15°W 31.68' (60d spike in W. side)

12" Poplar N10°W 28.45' Nail and washer marker #1237 in West side)

8" Maple N65°E 18.32' (60d spike in S. side)

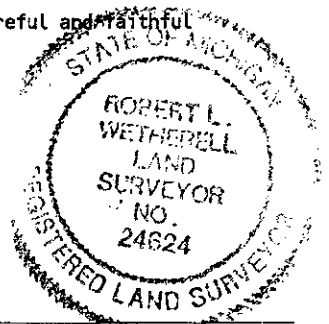

Signed by Robert L. Wetherell 24624

Date 10-28-97

Surveyor's Michigan License No.