

JAN 12 1995

COMMISSION

LAKE COUNTY REMONUMENTATION  
LAND CORNER RECORDATION CERTIFICATE  
Filing Requirement of Act 74, Mich. P.A. 1970

LIBER 003 PAGE 0316

REGISTER OF DEEDS  
*Shirley A. Brown*

SEP 5 3 06 PM '95

RECORDED  
LAKE COUNTY, MI.

or corners in

Lake (County)	Located In:		Corner Code #7
	19N	11W	
Public Land Survey	T	R	D-7
	T	R	
	T	R	
	T	R	
Property Controlling in Section	S	R	
	S	R	
Miscellaneous Property in Sec.	S	R	
	S	R	

Register of Deeds Stamp & File Number

Lot No. \_\_\_\_\_, Recorded Plat \_\_\_\_\_  
Private Claims \_\_\_\_\_

Robert L. Wetherell April 26, 1995


I hereby certify that under requirements of P.A. 74, Michigan P.A. of 1970, the corner points mentioned in lines 1 and 2 above were in conformance with regulations and rules therefore as required in the current manual of survey instructions of the United States Department of the Interior, Bureau of Land Management or by a decree of a Court of Law and/or that the corner points mentioned in lines 3, 4 and 5 above were in conformance with the rules of the Michigan Board of Land Surveyors or by a Decree of a Court of Law; established, re-established, monumented, re-monumented, recovered, found as expressed below:

NOTE: Not more than 4 corners, all in the same town and range, may be recorded on this certificate.

Description of original monument and accessories and/or subsequent restoration:

D-7 - 1/4 corner common to Sections 17 and 20, T19N, R11W, Ellsworth Twp., Lake Co., Mi.

1838 - S. Sibley, G.L.O.  
10" Beech S62°W 8 Links  
8" Beech N7°E 26 Links

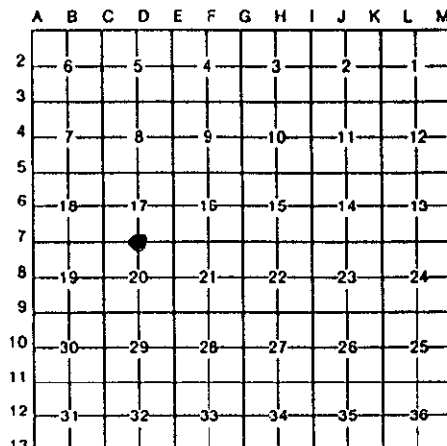

SURVEY &  
REMONUMENTATION

JAN 12 1996

COMMISSION

Description of corner evidence found and/or method applied in restoring or reestablishing corner:

D-7 - 1/4 corner common to Sections 17 and 20, T19N, R11W, Ellsworth Twp., Lake Co., Mi.

I could find no record of subsequent restoration since G.L.O. I did not find any monument or accessories at this corner. I re-established this corner by single proportionate method. The measured distance East and West to the respective Section corners being 2629.70 feet. This position fits an old stump fence (running North) at the East 1/16 line. The corner as established is 23 feet North of an old East and West fence (right of way fence).

RATIFIED BY THE LAKE CO. PEER REVIEW GROUP  
IN ACCORDANCE WITH P.A. 345  
CHAIRMAN *G. F. W.*  
DATE 8-29-95

Description of monument for corner and accessories established to perpetuate locating the position of the corner:

D-7 - 1/4 corner common to Sections 17 and 20, T19N, R11W, Ellsworth Twp., Lake Co., Mi.

I placed a 3/4" x 24" re-bar with Lake County Brass Cap, and is accepted as a careful and faithful re-establishment of the position of the original corner.

Guy Wire Anchor S77°W 13.60'  
8" R. Pine S6°E 28.58' (60d spike in E. side)  
7" R. Pine S50°E 50.86' (60d spike in N.E. side)  
6" J. Pine N72°W 16.60' (60d spike in N. side)  
6" J. Pine S71°E 54.30' (60d spike in S.E. side)

Signed by *Robert L. Wetherell* Date August 29, 1995  
Surveyor's Michigan License No. 24624

