

SURVEY & REMONUMENTATION

AUG 31 1999

LAND CORNER RECORDATION CERTIFICATE

FILING REQUIREMENT OF ACT 74, Mich. P.A. 1970

SECTION

For corners in Lake	Located in:	Corner Code#
1. Public Land Survey	T 19N	R 11W E-8
	T	R
	T	R
	T	R
2. Property Controlling in Section	T	R
	S T	R
3. Miscellaneous Property in Sec.	S T	R
	S T	R
4. Lot No. _____ Recorded Plat		
5. Private Claims		

RECORDED
LAKE COUNTY, MI.
LIBER 004 PAGE 0214
Jul 23 3 06 PM '99

Shirley H. DeClaw
REGISTER OF DEEDS

Register of Deeds Stamp & File Number

	A	B	C	D	E	F	G	H	I	J	K	L	M
1													
2	6	5	4	3	2	1							
3													
4	7	8	9	10	11	12							
5													
6	18	17	16	15	14	13							
7													
8	19	20	21	22	23	24							
9													
10	30	29	28	27	26	25							
11													
12	31	32	33	34	35	36							
13													

I, Robert L. Wetherell, in a field survey on June 14, 1999, do hereby certify that under requirements of P.A. 74, Michigan P.A. of 1970, the corner points mentioned in lines 1 and 2 above were in conformance with regulations and rules therefore as required in the current manual of survey instructions of the United States Department of the Interior, Bureau of Land Management or by decree of a Court of Law and/or that the corner points mentioned in lines 3, 4, and 5 above were in conformance with the rules of the Michigan Board of Land Surveyors or by a Decree Of a Court of Law; established, re-established, monumented, re-monumented, recovered, found as expressed below:

E-8 - 1/4 Corner Common to Sections 20 & 21, T19N, R11W

A. Description of original monument and accessories and/or subsequent restoration:

1838 - S. Sibley, G.L.O.

#1 - 12" Beech S29°E 47 Links
#2 - 8" Beech N5°W 28 Links

Undated - G. Johnson, Co. Sur.

#3 - 40" Pine Stump S61°W 13 Links

1906 - J. W. Nicholson, Co. Sur.

"Old post set by R.L. Russell years ago, no record, but accepted
#3 - 26" Pine Stump S59°W 13 Links

1918 - G. H. Johnson, Co. Sur.

1 1/2" Pipe
#4 - 5" Elm S17°30'W 43'
#5 - 6" Maple S41°E 84'
1998 - J.C. Kapelczak, LS 24508
Found 1 1/2" Pipe
#6 - 10" R. Pine N52°E 67.54'
#7 - Fence Post N30°W 91.87'
#8 - Fence Post S55°W 37.55'
#9 - 5" Cherry S35°E 38.46'

B. Description of corner evidence found and/or method applied in restoring of reestablishing corner:

I found a 1 1/2" galvanized pipe at the intersection of roads North, East and West and in line with old fence to the South. I don't believe that the pipe I found is the one called for by Johnson in 1918, but it does fit Johnson's Elm to the SW (18" Stump S22°W 42.6')


Condition of the accessories are as follows: #1 Gone, #2 Gone, #3 Gone, #4 Found Stump, #5 Gone, #6 Found in good condition, #7 Found in good condition, #8 Found in good condition, #9 Found in good condition.

C. Description of monument for corner and accessories established to perpetuate locating the position of the corner:

I replaced the 1 1/2" Pipe with a 3/4" x 24" re-bar with Lake County Remon Cap, and is accepted as a careful and faithful re-establishment of the position of the original corner.

- 11" R. Pine N28°E 89.43' (60d spike in W. side)
- 4" Ash (in clump of 3) S40°E 69.36' (60d spike in W. side)
- 10" R. Pine N52°E 67.57' (60d spike in S.W. side) #6
- 5" Cherry S35°E 38.28' (60d spike in N.W. side) #9

RATIFIED BY THE LAKE CO. PEER REVIEW GROUP
IN ACCORDANCE WITH P.A. 345
CHAIRMAN *R.W.*
DATE *7-20-99*

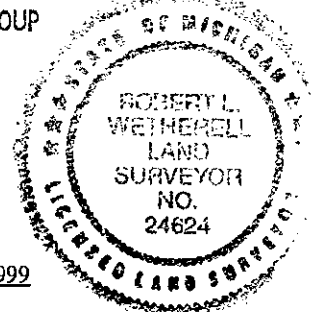

Signed by *Robert L. Wetherell*
Surveyor's Michigan License No. 24624

Date July 21, 1999