

NOV 15 1994

LIBER 003 PAGE 0229

COMMISSION

LAND CORNER RECORDATION CERTIFICATE
Filing Requirement of Act 74, Mich. P.A. 1970

For corners in
Lake

| (County) | Located In: | Corner Code # |
|------------------------------------|---------------|---------------|
| 1. Public Land Survey | T 19 N R 11 W | K-13 |
| | T R | |
| | T R | |
| | T R | |
| | T R | |
| 2. Property Controlling in Section | S T R | |
| | S T R | |
| 3. Miscellaneous Property in Sec. | S T R | |
| | S T R | |

RECORDED
LAKE COUNTY, MI.
OCT 7 3 46 PM '94
REGISTER OF DEEDS
Shirley M. Johnson

Register of Deeds Stamp & File Number

- 4. Lot No. _____, Recorded Plat _____
- 5. Private Claims _____

| | A | B | C | D | E | F | G | H | I | J | K | L | M |
|----|----|----|----|----|----|----|---|---|---|---|---|---|---|
| 2 | 6 | 5 | 4 | 3 | 2 | 1 | | | | | | | |
| 3 | | | | | | | | | | | | | |
| 4 | 7 | 8 | 9 | 10 | 11 | 12 | | | | | | | |
| 5 | | | | | | | | | | | | | |
| 6 | 18 | 17 | 16 | 15 | 14 | 13 | | | | | | | |
| 7 | | | | | | | | | | | | | |
| 8 | 19 | 20 | 21 | 22 | 23 | 24 | | | | | | | |
| 9 | | | | | | | | | | | | | |
| 10 | 30 | 29 | 28 | 27 | 26 | 25 | | | | | | | |
| 11 | | | | | | | | | | | | | |
| 12 | 31 | 32 | 33 | 34 | 35 | 36 | | | | | | | |
| 13 | | | | | | | | | | | | | |

I, Robert L. Wetherell, in a field survey on April 7, 1994, do hereby certify that under requirements of P.A. 74, Michigan P.A. of 1970, the corner points mentioned in lines 1 and 2 above were in conformance with regulations and rules therefore as required in the current manual of survey instructions of the United States Department of the Interior, Bureau of Land Management or by a decree of a Court of Law and/or that the corner points mentioned in lines 3, 4 and 5 above were in conformance with the rules of the Michigan Board of Land Surveyors or by a Decree of a Court of Law; established, re-established, monumented, re-monumented, recovered, found as expressed below:

NOTE: Not more than 4 corners, all in the same town and range, may be recorded on this certificate.

A. Description of original monument and accessories and/or subsequent restoration:

K-13 - (Sec. Corner common to Sections 35 & 36, T19N, R11W, on the South Line of Section).

1837 - John Hodgson, D.S. G.L.O.
#1 - 7" Beech N57°W 34 Links
#2 - 17" Beech N74°E 17 Links

1973 - Clinton E. Cole, L.S. 17615
Working in Section 1, T18N, R11W, used a 1/2" pipe. No accessories reported. Used standard corner. Closing corner is 40.92' East in line with road to South.

1980 - Robert L. Wetherell, LS 24624
1/2" Pipe by Clinton E. Cole
#3 - 10" Oak N48°E 45.73'
#4 - 14" W. Pine S1°W 57.92'
#5 - 10" Cherry S59°E 72.0'

1973 - James Granger, L.S. 16041
Traversed around Sec. 36, T19N, R11W, and used a fence post for S.W. corner. No accessories reported.

B. Description of corner evidence found and/or method applied in restoring or reestablishing corner:

K-13 - (Sec. Corner common to Sections 35 & 36, T19N, R11W, on the South Line of Section).


I found the 1/2" pipe I used in 1980. I found the fence post, apparently used by Surveyor Granger, approximately 26 feet East. The 1/2" pipe was in an East and West fence line and 23 feet more or less East of a fence running North and 31 feet West of another fence running North (an apparent lane that runs the entire mile North between Sections 35 and 36). G.L.O. reported a stream crossing 218 feet East of this corner, from the 1/2" pipe I measured 226 feet East to the stream. The distance to the Township corner to the East measures 5251.42 feet and the the Southwest corner of Section 35 it measures 5223.44 feet.

C. Description of monument for corner and accessories established to perpetuate locating the position of the corner:

K-13 - (Sec. Corner common to Sections 35 & 36, T19N, R11W, on the South Line of Section).

I replaced the 1/2" pipe with a 3/4" x 24" re-bar with Lake County Brass Cap, and is accepted as a careful and faithful re-establishment of the position of the original corner.

- 16" B. Oak N48°E 45.54' (60d spike in N.W. side of tree) (#3)
- 13" Twin W. Pine N11°E 45.81'
- Railroad tie fence post East 29.66' (60d spike in North side)
- 20" W. Pine due South 57.52' (60d spike n West side) (#4)
- 5/8" Brass capped re-bar (N.E. cor. Sec. 2, T18N, R11W) East 40.92'

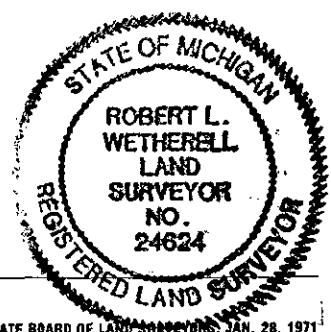

Signed by *Robert L. Wetherell* Date October 4, 1994

Surveyor's Michigan License No. _____
 RATIFIED BY THE LAKE CO. PEER REVIEW GROUP
 IN ACCORDANCE WITH P.A. 345
 CHAIRMAN *R.L.W.*