

**SURVEY &
REMONUMENTATION**

AUG 31 1999

LAND CORNER RECORDATION CERTIFICATE

FILING REQUIREMENT OF ACT 74, Mich. P.A. 1970

SECTION

RECORDED
LAKE COUNTY, MI.
LIBER 004 PAGE 0210
JUL 23 3 05 PM '99

Stephen H. Dechant
REGISTER OF DEEDS

For corners in Lake _____	Located in:	Corner Code#
1. Public Land Survey	T 19N	R 11W M-10
	T	R
	T	R
	T	R
2. Property Controlling in Section	S T	R
	S T	R
3. Miscellaneous Property in Sec.	S T	R
	S T	R
4. Lot No. _____ Recorded Plat		
5. Private Claims _____		

Register of Deeds Stamp & File Number

	A	B	C	D	E	F	G	H	I	J	K	L	M
1													
2	6	5	4	3	2	1							
3													
4	7	8	9	10	11	12							
5													
6	18	17	16	15	14	13							
7													
8	19	20	21	22	23	24							
9													
10	30	29	28	27	26	25							
11													
12	31	32	33	34	35	36							
13													

I, Robert L. Wetherell, in a field survey on June 1, 1999, do hereby certify that under requirements of P.A. 74, Michigan P.A. of 1970, the corner points mentioned in lines 1 and 2 above were in conformance with regulations and rules therefore as required in the current manual of survey instructions of the United States Department of the Interior, Bureau of Land Management or by decree of a Court of Law and/or that the corner points mentioned in lines 3, 4, and 5 above were in conformance with the rules of the Michigan Board of Land Surveyors or by a Decree Of a Court of Law; established, re-established, monumented, re-monumented, recovered, found as expressed below:

M-10 - E. 1/4 Corner Section 25, T19N, R11W

A. Description of original monument and accessories and/or subsequent restoration:

1837 - J. Hodgson, G.L.O.

#1 - 7" Beech S49°W 13 Links

#2 - 7" Beech N76°W 42 Links

1891 - 1904 - A. Temple/F. Trumbull

Remonumentation of T19N R10W

Set 3" Clay Tiles

1922 - Osceola Co. Sur. Records

"Tile & Rod"

#3 - Tri-Maple NE 106.4'

#4 - Hemlock SW 59'

1954 - L. Slater (M.S.H.D.)

1/2" Rod in Vit. Tile

#5 - 5" Maple N67°W 37.16'

#4 - 36" hemlock S46°W 59.98'

#6 - P. Pole S84°E 49.65'

1971 - P. Salisbury, LS 13594

#4 - 40" Pine S45°W 59.49'

#5 - 14" Maple N70°W 37.17'

#6 - P. Pole S85°E 49.60'

1987 - Henry Mulder, LS 25862

L.C.R.C. - L. 03, Pg. 048

Found 1/2" Rod in Tile.

#6 - Face of P. Pole S84°E 49.48'

#5 - 13" Maple N67°W 37.40'

#7 - Fence Post N88°E 33.73'

#3 - 40" Maple N20°E 107.75'

1998 - P. Trinklein, LS 43072

Found 3/8" Bolt in 3/4" Pipe

#8 - Found B & C #16923 - S82°E 33.06'

#6 - Utility Pole S73°E 51.00'

#5 - 21" Maple N60°W 37.36'

#9 - 17" Maple S52°W 38.40'

B. Description of corner evidence found and/or method applied in restoring of reestablishing corner:

I found a 3/8" Bolt in center of 3" Clay Tile with cinders.

Condition of the accessories are as follows: #1 Gone, #2 Gone, #3 Found in good condition, #4 Gone, #5 Found in good condition, #6 Replaced, #7 Gone, #8 Found in good condition, #9 Found in good condition.

C. Description of monument for corner and accessories established to perpetuate locating the position of the corner:

I replaced the 3/8" bolt with a 3/4" x 24" re-bar with Lake County Remon Cap, and is accepted as a careful and faithful re-establishment of the position of the original corner.


14" Maple S52°W 38.28' (Nail in S. side) #9

18" Maple N60°W 37.38' (Nail in N. side) #5

Utility Pole S73°E 51.00' (P.K. Nail in N. side) #6

12" R. Pine N59°E 51.04' (60d spike in N. side)

RATIFIED BY THE LAKE CO. PEER REVIEW GROUP
IN ACCORDANCE WITH P.A. 345
CHAIRMAN *RW*
DATE 7-20-99

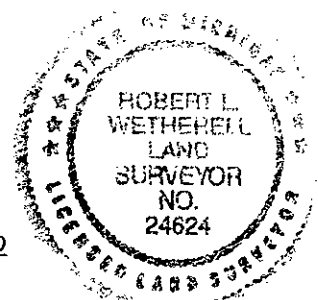

Signed by *Robert L. Wetherell*
Surveyor's Michigan License No. 24624

Date July 21, 1999