

JAN 25 2001

LAND CORNER RECORDATION CERTIFICATE

FILING REQUIREMENT OF ACT 74, Mich. P.A. 1970

SECTION

RECORDED
LAKE COUNTY, MI 239
LIBER 004 PAGE 0239

MAY 5 10 25 AM '00

Shelley Myers
REGISTER OF DEEDS

Register of Deeds Stamp & File Number

For corners in Lake _____	Located in:	Corner Code#
1. Public Land Survey	T 19 N R 11 W	M-6
	T R	
	T R	
	T R	
2. Property Controlling in Section	S T R	
	S T R	
3. Miscellaneous Property in Sec.	S T R	
	S T R	
4. Lot No. _____ Recorded Plat _____		
5. Private Claims _____		

	A	B	C	D	E	F	G	H	I	J	K	L	M
1													
2	6	5	4	3	2	1							
3													
4	7	8	9	10	11	12							
5													
6	18	17	16	15	14	13							
7													
8	19	20	21	22	23	24							
9													
10	30	29	28	27	26	25							
11													
12	31	32	33	34	35	36							
13													

I, Robert L. Wetherell, in a field survey on March 1, 2000, do hereby certify that under requirements of P.A. 74, Michigan P.A. of 1970, the corner points mentioned in lines 1 and 2 above were in conformance with regulations and rules therefore as required in the current manual of survey instructions of the United States Department of the Interior, Bureau of Land Management or by decree of a Court of Law and/or that the corner points mentioned in lines 3, 4, and 5 above were in conformance with the rules of the Michigan Board of Land Surveyors or by a Decree Of a Court of Law, established, re-established, monumented, re-monumented, recovered, found as expressed below:

M-6 - E 1/4 Corner Sections 13, T19N, R11W

A. Description of original monument and accessories and/or subsequent restoration:

1837 - J. Hodgeson, G.L.O.
#1 - 7" Beech S28°W 25 Links
#2 - 7" Beech N52°W 34 Links

1905 - J.W. Nicholson, Lake Co. Sur.
#3 - 12" Elm S32°E 70 Links

1959 - F. McClung, Osceola Co. Sur.
Tile & Rod
#5 - Tw. Maple N.W. 40 1/2'
#6 - 12" Elm W. 82'
#7 - 10" Elm E. 51'

1892-1904 - Temple/Trumbull
Remonumented entire Leroy Twp.
(T19N, R10W) with 3" Clay Tiles
with cinders.

Undated G.H. Johnson, Lake Co. Sur.
#3 - 12" Elm S32°E 70 Links
#4 - 14" Elm Stump N26 1/2°E 14 Links

1980 - R.L. Wetherell, LS 24624
1/2" Rod
#8 - Fence Post N85°W 25.09'
#9 - 4" Maple S42°E 39.70'
#10 - 6" Maple N33°E 53.06'

B. Description of corner evidence found and/or method applied in restoring or reestablishing corner:

I found the 1/2" rod I found in 1980. Below rod I found the 3" Glazed Tile with Cinders. Corner is in the centerline of North and South road.


Condition of the accessories are as follows: #1 Gone, #2 Gone, #3 Found remains of stump, #4 Gone, #5 Gone, #6 Gone, #7 Gone, #8 New Post, #9 Found in good condition, #10 Found in good condition.

C. Description of monument for corner and accessories established to perpetuate locating the position of the corner:

I set a 3/4" x 24" Rebar with Lake County Remon Cap in the center of the clay tile and is accepted as a careful and faithful reestablishment of the position of the original corner.

- 13" Maple N46°W 85.03' (60d spike in N.E. side)
- 8" Tri-Maple N68°W 61.40' (60d spike in N.E. side)
- 8" Maple S40°E 39.67' (60d spike in N.E. side) O.B.T. #9
- 4" W. Pine N53°E 46.30' (60d spike in N.W. side)

RAITIFIED BY THE LAKE CO. DEED REVIEW GROUP
IN ACCORDANCE WITH P.A. 345
CHAIRMAN R.L.W.
DATE 4-11-00

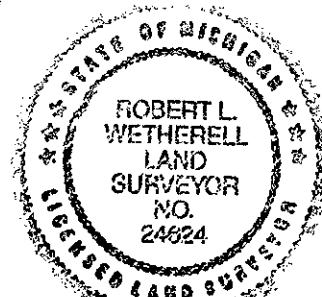

Signed by Robert L. Wetherell
Surveyor's Michigan License No. 24624

Date April 12, 2000