# LAND CORNER RECORDATION CERTIFICATE

**Filing Requirement of Act 74, Mich. P.A. 1970**

For corners in
LAKE
(County)

| | | Located In: | Corner Code 44 |
|---|---|---|---|
| 1. Public Land Survey | | T 19N R 12W | L-9 |
| | | T R | |
| | | T R | |
| | | T R | |
| 2. Property Controlling | S 25 | T R | 5 |
| in Section | S | T R | |
| 3. Miscellaneous | S | T R | |
| Property in Sec. | S | T R | |

**Register of Deeds Stamp & File Number**

4. Lot No. _____, Recorded Plat _____
5. Private Claims _____

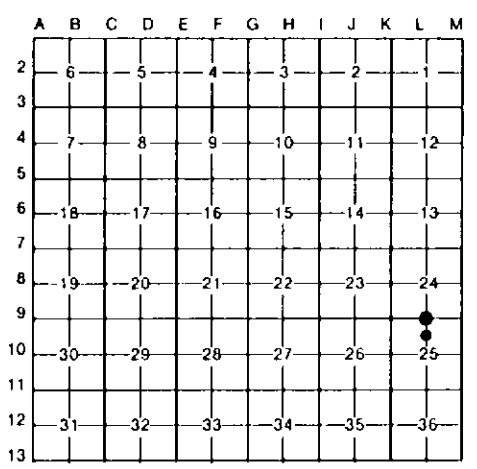


I, C.F.ROSER, in a field survey on 1-31, 19 91, do hereby certify that under requirements of P.A. 74, Michigan P.A. of 1970, the corner points mentioned in lines 1 and 2 above were in conformance with regulations and rules therefore as required in the current manual of survey instructions of the United States Department of the Interior, Bureau of Land Management or by a decree of a Court of Law and/or that the corner points mentioned in lines 3, 4 and 5 above were in conformance with the rules of the Michigan Board of Land Surveyors or by a Decree of a Court of Law; established, re-established, monumented, re-monumented, recovered, found as expressed below.

**NOTE: Not more than 4 corners, all in the same town and range, may be recorded on this certificate.**

A. Description of original monument and accessories and/or subsequent restoration:

L-9 5

B. Description of corner evidence found and/or method applied in restoring or reestablishing corner:

L-9
FD CONSERVATION DEPT MON FOR N1/4 COR SEC 25. IN 1973 C.F.ROSER ACCEPTED OLD COR FN POST, FN E-W-S MOSTLY DOWN, AS PROPER 1/4 COR.

5
ESTABLISHED NW COR OF SW1/4 OF NE1/4 OF SEC 25 PER STANDARD BLM INSTRUCTIONS. FD OLD FN COR DOWN (FN REMAINS N & E), S37°W. 58'.

C. Description of monument for corner and accessories established to perpetuate locating the position of the corner:

L-9
FD CONSERVATION DEPT MON:
ADDED CEDAR POST.

| | | |
|---|---|---|
| 7" MAPLE | N55°W | 35.3' |
| 7" MAPLE | S85°E | 16.0' |
| 10" R.OAK | S40°E | 59.1' |
| *10" MAPLE | S30°W | 19.5' |

5
DROVE 5/8"x 34" REROD W/LS CAP & SET CEDAR POST W/LOC TAG.

| | | |
|---|---|---|
| 6" W.OAK | N70°W | 4.6' |
| 6" W.OAK | N35°W | 7.9' |
| 2" W.PINE | S20°E | 14.4' |

* 1973 DNR WIT.

STATE OF MICHIGAN
CARL F. ROSER
LAND SURVEYOR
No. 12028
REGISTERED LAND SURVEYOR

Signed by Carl F. Roser 2-04-91 Date

Surveyor's Michigan License No. 12028

FORM APPROVED BY MICHIGAN STATE BOARD OF LAND SURVEYORS, JAN. 28, 1971
REVISED MAY 14, 1975
REVISED JAN., 1983