

*Mail to
Lansing Forestry*

STATE OF MICHIGAN
DEPARTMENT
OF
NATURAL RESOURCES

LAND CORNER RECORD


LAKE COUNTY
T 19 N R 12 W

DESCRIPTION OF CORNER South 1/4 corner - Section 31

CORNER MONUMENT Found F. Jones corner - added DNR monument.

DATE MONUMENT PLACED AND WITNESSED 6-12-72

WITNESSES TO CORNER..... J. Pine 9" N 02 E 36.3'

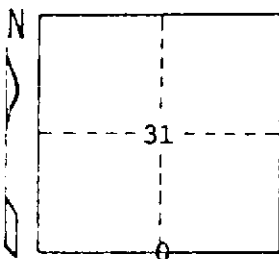

B. Oak 9" N 35 W 41.5'


Ctr. E-W sand road Due S 74.0'

AND

CIRCLE CORNER REGISTERED

DESCRIPTION IN DETAIL AS TO HOW CORNER WAS LOCATED AND IDENTIFIED OR RESTORED.

Recovered F. Jones corner of record from his witness. North 1/4 corner, Section 6,
T18N - R12W is East ~~7.6'~~
15.2'
✓

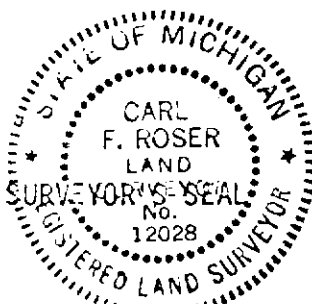

DISTRIBUTION:

Forestry Division, Lansing

SIGNED

Carl F. Roser
REGISTERED LAND SURVEYOR 12028

DATE

6-19-72

*Corrected
CFR
1-15-73*

7 4.67