

STATE OF MICHIGAN
DEPARTMENT
OF
NATURAL RESOURCES

LAND CORNER RECORD


LAKE COUNTY
T 19 N R 12 W

DESCRIPTION OF CORNER SE corner - Section 31

CORNER MONUMENT Set DNR monument

DATE MONUMENT PLACED AND WITNESSED 6-12-72

WITNESSES TO CORNER..... J. Pine 7" N 43 W 83.1'

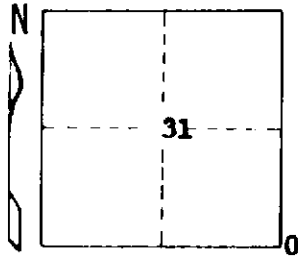


B. Oak 11" S 63 W 65.5'

AND

CIRCLE CORNER REGISTERED

DESCRIPTION IN DETAIL AS TO HOW CORNER WAS LOCATED AND IDENTIFIED OR RESTORED.

**Re-established corner per standard BLM instructions. The NE corner of Section 6,
T18N - R12W is 15.2' East.**

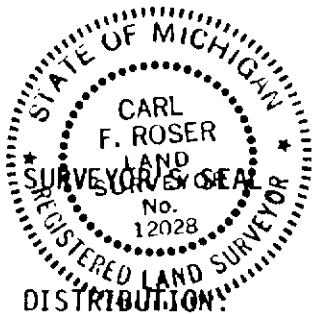

SIGNED

Carl F. Roser
REGISTERED LAND SURVEYOR 12028

DATE

6-19-72

Forestry Division, Lansing