

MAY 16 1997

COMMISSION

LAND CORNER RECORDATION CERTIFICATE
Filing Requirement of Act 74, Mich. P.A. 1970

LIBER003 PAGE0398

For corners in

Lake (County)	Located In:	Corner Code #
1. Public Land Survey	19N 13W	M-5
	T 19N R 12W	A-5
	T R	
	T R	
	T R	
2. Property Controlling in Section	S T R	
	S T R	
3. Miscellaneous Property in Sec.	S T R	
	S T R	

RECORDED
LAKE COUNTY, MI.
NOV 14 11 26 AM '96
REGISTER OF DEEDS
Register of Deeds Stamp & File Number

- 4. Lot No. _____, Recorded Plat _____
- 5. Private Claims _____

A	B	C	D	E	F	G	H	I	J	K	L	M
2	6	5	4	3	2	1						
3												
4	7	8	9	10	11	12						
5												
6	18	17	16	15	14	13						
7												
8	19	20	21	22	23	24						
9												
10	30	29	28	27	26	25						
11												
12	31	32	33	34	35	36						
13												

I, Robert L. Wetherell, in a field survey on March 1, 1996, do hereby certify that under requirements of P.A. 74, Michigan P.A. of 1970, the corner points mentioned in lines 1 and 2 above were in conformance with regulations and rules therefore as required in the current manual of survey instructions of the United States Department of the Interior, Bureau of Land Management or by a decree of a Court of Law and/or that the corner points mentioned in lines 3, 4 and 5 above were in conformance with the rules of the Michigan Board of Land Surveyors or by a Decree of a Court of Law, established, re-established, monumented, re-monumented, recovered, found as expressed below:

NOTE: Not more than 4 corners, all in the same town and range, may be recorded on this certificate.


A. Description of original monument and accessories and/or subsequent restoration:
M-5 & A-5 - Section corner common to Sections 12 & 13, T19N, R13W, AND Sections 7 and 18, T19N, R12W, Lake Co., Mi.

- | | | |
|------------------------------------------------------------------------------------------|---|---|
| 1838 - S. Sibley, G.L.O.
#1 - 26" Pine S53°W 37 Links
#2 - 10" Pine N45°W 21 Links | 1941 - George Blass, LS 5489
Iron pin set from found original
Government Bearing Trees
#3 - 10 J. Pine S76°W 29.30'
#4 - 14" B. Oak N27°W 66.30'
#5 - 12" W. Oak S61°E 93.00' | 1968 - Carl Roser, LS 12028
Found iron pin and replaced with
D.N.R. Monument.
#6 - 24" Oak N60°E 64.8'
#7 - 26" Oak N30°W 82.50'
#8 - 26" Oak S88°W 52.20' |
|------------------------------------------------------------------------------------------|---|---|

B. Description of corner evidence found and/or method applied in restoring or reestablishing corner:
M-5 & A-5 - Section corner common to Sections 12 & 13, T19N, R13W, AND Sections 7 and 18, T19N, R12W, Lake Co., Mi.

I found the D.N.R. Monument on the North edge of East and West road. I also found accessories No. 3, No. 5, No. 7 and No. 8 in good condition. Accessory No. 6 was found dead. Accessories No. 1 and No. 2 were gone.

RATIFIED BY THE LAKE CO. PEER REVIEW GROUP
IN ACCORDANCE WITH P.A. 945
CHAIRMAN R.L.W.
DATE 11-12-96

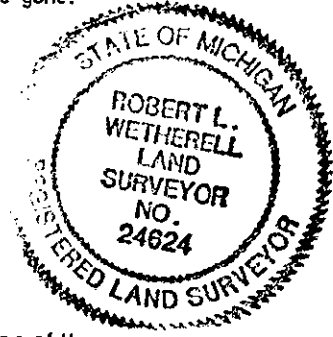

C. Description of monument for corner and accessories established to perpetuate locating the position of the corner:
M-5 & A-5 - Section corner common to Sections 12 & 13, T19N, R13W, AND Sections 7 and 18, T19N, R12W, Lake Co., Mi.

I accepted the D.N.R. monument as a substantial monument for the corner, and is a perpetuation of the original corner.

- 32" B. Oak N86°W 53.72' (Found nail in S. side) #8
- 30" B. Oak N24°W 83.67' (Found nail in W. side) #7
- 6" B. Oak S81°E 29.30' (60d nail in N. side)
- 6" B. Oak S38°W 31.19' (60d nail in E. side)

Signed by Robert L. Wetherell Date 11-13-1996
Surveyor's Michigan License No. 24624

177-178