

SURVEY & REMONUMENTATION

JAN 14 1998

LAND CORNER RECORDATION CERTIFICATE
 Filing Requirement of Act 74, Mich. P.A. 1970

For corners in **SECTION**


Lake (County)	Located In:		Corner Code #/
	19N	12W	
1. Public Land Survey	T	R	E-5
	T	R	
	T	R	
	T	R	
2. Property Controlling in Section	S	T	R
	S	T	R
3. Miscellaneous Property in Sec.	S	T	R
	S	T	R

RECORDED
LAKE COUNTY, MI.
LIBER 004 PAGE 0086
DEC 12 11 37 AM '97

Lucinda H. Dickard
REGISTER OF DEEDS

Register of Deeds Stamp & File Number

4. Lot No. _____, Recorded Plat _____
 5. Private Claims _____

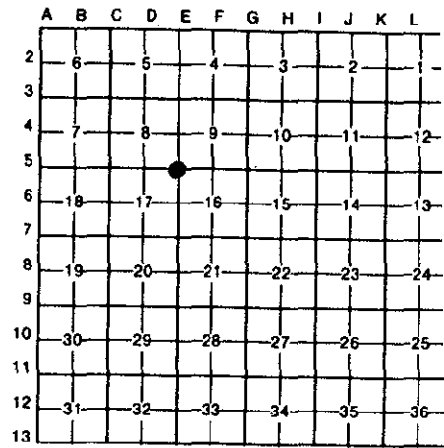

I, Robert L. Wetherell, in a field survey on October 18, 1997, do hereby certify that under requirements of P.A. 74, Michigan P.A. of 1970, the corner points mentioned in lines 1 and 2 above were in conformance with regulations and rules therefore as required in the current manual of survey instructions of the United States Department of the Interior, Bureau of Land Management or by a decree of a Court of Law and/or that the corner points mentioned in lines 3, 4 and 5 above were in conformance with the rules of the Michigan Board of Land Surveyors or by a Decree of a Court of Law; established, re-established, monumented, re-monumented, recovered, found as expressed below:

NOTE: Not more than 4 corners, all in the same town and range, may be recorded on this certificate.

A. Description of original monument and accessories and/or subsequent restoration:

- E-5 - Section Corner common to Sections 8, 9, 16 & 17, T19N, R12W, Lake Co., MI.
- | | | |
|--|---|---|
| <u>1838 - S. Sibley, G.L.O.</u> | <u>1963 - George Blass, LS 5489</u> | <u>1997 - Ken Ross, LS 17634</u> |
| #1 - 20" Pine N45 ^o W 33 Links | Found "T" Iron fence post from old witnesses. | L.C.R.C. - Liber 03, Pg. 426 |
| #2 - 6" W. Oak S19 ^o E 24 Links | | Found "T" Iron Fence Post |
| <u>Undated - George Johnson, Co. Sur.</u> | #5 - 8" B. Oak S57 ^o E 21.05' | #5 - 16" B. Oak S57 ^o E 21.05' |
| #3 - 10" B. Oak N.W. 22' | #6 - 10" B. Oak S3 ^o E 38.70' | #6 - 22" B. Oak S3 ^o E 38.70' |
| #4 - 12" B. Oak N.E. 17' | #3 - 16" B. Oak N72 ^o W 23.47' | #7 - 6" W. Pine N65 ^o E 36.30' |
| | | #8 - 16" B. Oak S62 ^o W 31.60' |

B. Description of corner evidence found and/or method applied in restoring or reestablishing corner:

E-5 - Section Corner common to Sections 8, 9, 16 & 17, T19N, R12W, Lake Co., MI.

I found a "T" Iron Fence Post 24" Long in line with roads to North and West.

Condition of the accessories are as follows: #1 Gone, #2 Gone, #3 Found stump, #4 Found Stump, #5 Found in good condition, #6 Found in good condition, #7 Found in good condition, #8 Found in good condition.

RATIFIED BY THE LAKE CO. PEER REVIEW GROUP
 IN ACCORDANCE WITH P.A. 345
 CHAIRMAN *R.L.W.*
 DATE 12-10-97

C. Description of monument for corner and accessories established to perpetuate locating the position of the corner:

E-5 - Section Corner common to Sections 8, 9, 16 & 17, T19N, R12W, Lake Co., MI.

I replaced the "T" Iron Fence Post with a 3/4" x 24" re-bar with Lake County Brass Cap, and is accepted as a careful and faithful re-establishment of the position of the original corner.

- 6" W. Pine N65^oE 36.30' (60d spike in N.W. side) #7
- 12" R. Pine N55^oW 108.66' (60d spike in N.E. side)
- 12" & 16" Tw. B. Oak S2^oW 39.01' (60d spike in E. side) #6
- 7" W. Oak S55^oE 21.44' (60d spike in S. side) #5
- 7" R. Pine N32^oE 32.26' (60d spike in E. side)
- 13" W. Oak S82^oE 50.60' (60d spike in N. side)

Signed by Robert L. Wetherell
 Surveyor's Michigan License No. 24624

Date 12-12-97

