

**SURVEY &
REMONUMENTATION**

AUG 31 1999

LAND CORNER RECORDATION CERTIFICATE

FILING REQUIREMENT OF ACT 74, Mich. P.A. 1970

SECTION

For corners in Lake _____	Located in:	Corner Code#	
1. Public Land Survey	T19N	R 12W	H-13
	T	R	
	T	R	
	T	R	
2. Property Controlling s in Section	T	R	
	S	T	R
3. Miscellaneous Property in Sec.	S	T	R
	S	T	R
4. Lot No. _____ Recorded Plat			
5. Private Claims _____			

RECORDED
LAKE COUNTY, MI.

LIBER 004 PAGE 0203
JUL 23 3 04 PM '99

Shirley H. Beckwith
REGISTER OF DEEDS

Register of Deeds Stamp & File Number

I, Robert L. Wetherell, in a field survey on February 1, 1999, do hereby certify that under requirements of P.A. 74, Michigan P.A. of 1970, the corner points mentioned in lines 1 and 2 above were in conformance with regulations and rules therefore as required in the current manual of survey instructions of the United States Department of the Interior, Bureau of Land Management or by decree of a Court of Law and/or that the corner points mentioned in lines 3, 4, and 5 above were in conformance with the rules of the Michigan Board of Land Surveyors or by a Decree Of a Court of Law; established, re-established, monumented, re-monumented, recovered, found as expressed below:

	A	B	C	D	E	F	G	H	I	J	K	L	M
1													
2	6	5	4	3	2	1							
3													
4	7	8	9	10	11	12							
5													
6	18	17	16	15	14	13							
7													
8	19	20	21	22	23	24							
9													
10	30	29	28	27	26	25							
11													
12	31	32	33	34	35	36							
13													

H-13 - S.1/4 Corner Section 34, T19N, R12W

A. Description of original monument and accessories and/or subsequent restoration:

1837 - J. Hodgson, G.L.O.
#1 - 17" Pine N29°W 21 Links
#2 - 18" Pine N38°E 56 Links

1973 - C. Roser, LS 12028
L.C.R.C. - L. 02, Pg. 152
"Set D.N.R. Monument from two U.S. bearing tree remains"
#3 - 14" R. Oak N65°W 16.3'
#4 - 6" Maple N33°E 25.3'
#5 - N. 1/4 Corner Sec. 3, T18N, R12W - Due East 19.38'

1977 - J. Erickson, LS 16929
Survey recorded L. 02, Pg. 187
Found D.N.R. Monument
"Same witnesses as Roser's of 1973"

B. Description of corner evidence found and/or method applied in restoring or reestablishing corner:

I found the D.N.R. Monument (1- 1/2" Pipe with aluminum cap).


Condition of the accessories are as follows: #1 Found rotted stump #2 Found rotted stump, #3 Found stump, #4 Found stump, #5 Found in good condition.

C. Description of monument for corner and accessories established to perpetuate locating the position of the corner:

I accepted the D.N.R. Monument as a substantial marker for the corner, and is accepted as a careful and faithful perpetuation of the position of the original corner.

D.N.R. Capped Pipe - East 19.38' (N. 1/4 Corner Sec. 3, T18N, R12W)
5" Poplar N23°W 24.63' (60d spike in E. side)
5" R. Oak N66°W 15.74' (60d spike in S. side)
3" R. Oak S27°W 48.87' (60d spike in W. side)

RATIFIED BY THE LAKE CO. PEER REVIEW GROUP
IN ACCORDANCE WITH P.A. 345
CHAIRMAN *R.W.*
DATE 7-20-99

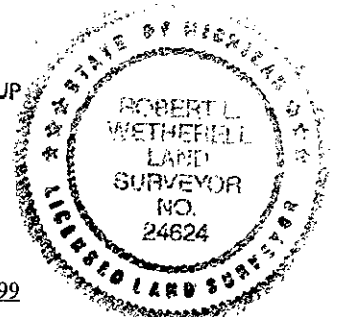

Signed by Robert L. Wetherell

Date July 21, 1999

Surveyor's Michigan License No. 24624