

JAN 25 2001

LAND CORNER RECORDATION CERTIFICATE

SECTION

FILING REQUIREMENT OF ACT 74, Mich. P.A. 1970

For corners in Lake _____	Located in:	Corner Code#
1. Public Land Survey	T 19 N R 12 W	I-3
	T R	
	T R	
	T R	
2. Property Controlling in Section	S T R	
	S T R	
3. Miscellaneous Property in Sec.	S T R	
	S T R	
4. Lot No. _____ Recorded Plat _____		
5. Private Claims _____		

RECORDED
LAKE COUNTY, MI.
LIBER 004 PAGE 0253
MAY 5 10 27 AM '00
Shelley Myers
REGISTER OF DEEDS

Register of Deeds Stamp & File Number

I, Robert L. Wetherell, in a field survey on February 23, 2000, do hereby certify that under requirements of P.A. 74, Michigan P.A. of 1970, the corner points mentioned in lines 1 and 2 above were in conformance with regulations and rules therefore as required in the current manual of survey instructions of the United States Department of the Interior, Bureau of Land Management or by decree of a Court of Law and/or that the corner points mentioned in lines 3, 4, and 5 above were in conformance with the rules of the Michigan Board of Land Surveyors or by a Decree Of a Court of Law, established, re-established, monumented, re-monumented, recovered, found as expressed below:

I-3 - Section corner common to Sections 2, 3, 10 & 11, T19N, R12W

	A	B	C	D	E	F	G	H	I	J	K	L	M
1													
2	6	5	4	3	2	1							
3													
4	7	8	9	10	11	12							
5													
6	18	17	16	15	14	13							
7													
8	19	20	21	22	23	24							
9													
10	30	29	28	27	26	25							
11													
12	31	32	33	34	35	36							
13													

A. Description of original monument and accessories and/or subsequent restoration:

1838 - S. Sibley, G.L.O.

- #1 - 8" Pine S29°E 4 Links
- #2 - 6" Pine N74°W 6 Links

1907 - J.W. Nicholson, Co. Sur.

- #3 - 14" B. Oak N34°W 65 Links
- #4 - Measured 2640' North
- #5 - Measured 2639' West

1927 - G.H. Johnson, Co. Sur.

- Set Iron Pipe
- #6 - 6" B. Oak S73°W 55.4'
- #7 - 6" B. Oak N20°45'E 68'
- #8 - Measured 5249' East

1974 - C. Cole, LS 24624

- L.C.R.C. Liber 02, Pg. 262
- Found iron raised with 1/2" rebar.
- #9 - P. Pole N18°E 123.69'
- #10 - P. Pole N64°W 103.15'
- #11 - 12" B. Oak S27°E 99.15'

1980 - C. Roser, LS 12028

- L.C.R.C. Liber 02, Pg. 386.
- "Found 1/2" iron".
- Same witness as C. Cole, 1974.

1999 - R. L. Wetherell, LS 24624

- Survey recorded Liber 04, Pg. 360.
- #11 - 18" B. Oak S24°E 98.84'
- #12 - 4" R. Pine S61°E 80.0'
- #13 - 10" W. Oak N83°E 147.11'
- #10 - P. Pole N61°W 102.89'

B. Description of corner evidence found and/or method applied in restoring or reestablishing corner:

I found Cole's 1/2" rebar directly over an old 1- 1/2" pipe in the intersection of roads North, South, East and West.


Condition of the accessories are as follows: #1 Gone, #2 Gone, #3 Gone, #4 Measured 2642.80', #5 Measured 2644.9', #6 Gone, #7 Gone, #8 Measured 5244.25', #9 Found in good condition, #10 Found in good condition, #11 Found in good condition.

C. Description of monument for corner and accessories established to perpetuate locating the position of the corner:

I replaced the 1/2" rod with a 3/4" x 24" rebar with Lake County Remon Cap, and is accepted as a careful and faithful reestablishment of the position of the original corner.

- 18" B. Oak S24°E 98.84' (60d spike in W. side) #11
- 4" R. Pine S61°E 80.0' (center of tree)
- 10" W. Pine N83°E 147.11' (60d spike in S. side)
- P. Pole N61°W 102.89' (60d spike in S.W. side) #10

REVIEW GROUP
CHAIRMAN R.L.W.
DATE 4-11-2000

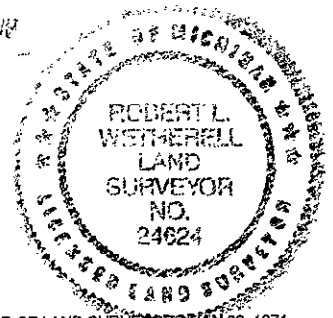

Signed by Robert L. Wetherell
Surveyor's Michigan License No. 24624

Date April 12, 2000