

**SURVEY & REMONUMENTATION**

**JAN 25 2001**

**LAND CORNER RECORDATION CERTIFICATE**

FILING REQUIREMENT OF ACT 74, Mich. P.A. 1970

**SECTION**

For corners in Lake _____	Located in:	Corner Code#
1. Public Land Survey	T 19 N R 12 W	J-2
	T R	
	T R	
	T R	
2. Property Controlling in Section	S T R	
	S T R	
3. Miscellaneous Property in Sec.	S T R	
	S T R	
4. Lot No. _____ Recorded Plat _____		
5. Private Claims _____		

RECORDED  
LAKE COUNTY, MI.  
LIBER 004 PAGE 0255  
MAY 5 10 27 AM '00  
*Shelley Meyers*  
REGISTER OF DEEDS

Register of Deeds Stamp & File Number

I, Robert L. Wetherell, in a field survey on March 1, 2000, do hereby certify that under requirements of P.A. 74, Michigan P.A. of 1970, the corner points mentioned in lines 1 and 2 above were in conformance with regulations and rules therefore as required in the current manual of survey instructions of the United States Department of the Interior, Bureau of Land Management or by decree of a Court of Law and/or that the corner points mentioned in lines 3, 4, and 5 above were in conformance with the rules of the Michigan Board of Land Surveyors or by a Decree of a Court of Law; established, re-established, monumented, re-monumented, recovered, found as expressed below:

**J-2 - Center 1/4 Corner Section 2, T19N, R12W, Lake Co., MI.**

	A	B	C	D	E	F	G	H	I	J	K	L	M
1													
2	6	5	4	3	2	1							
3													
4	7	8	9	10	11	12							
5													
6	18	17	16	15	14	13							
7													
8	19	20	21	22	23	24							
9													
10	30	29	28	27	26	25							
11													
12	31	32	33	34	35	36							
13													

**A. Description of original monument and accessories and/or subsequent restoration:**

**1999 - R.L. Wetherell, LS 24624**  
Survey recorded in Liber 004, Page 361.  
Found 4" x 18" x 1/2" Iron Bar with  
Clay bricks around it.

**B. Description of corner evidence found and/or method applied in restoring or reestablishing corner:**


I found the 4" x 48" x 1/2" iron bar I found in 1999. Corner is in the center of North and South road and in line with fences East and West.  
This iron bar is 4.3 feet North and 6.21 feet West of the true intersection of 1/4 lines. Accepted as the true corner.

**C. Description of monument for corner and accessories established to perpetuate locating the position of the corner:**

This position not established by original Government Surveyors. I placed a 3/4" x 24" rebar with Lake County Remon Cap over the Iron Bar and is accepted as the best available evidence of the position of the corner.

- 7" Cherry S32°W 107.53' (60d spike in N.W. side)
- 30" W. Oak S88°W 225.43' (60d spike in S. side)
- Corner fence post - East 30.53' (60d spike in N. side)
- 12" R. Pine N71°E 56.32' (60d spike in N.W. side)

WATIFIED BY THE LAKE CO. PEER REVIEW GROUP  
IN ACCORDANCE WITH P.A. 345  
CHAIRMAN *R.L.W.*  
DATE 4-11-2000

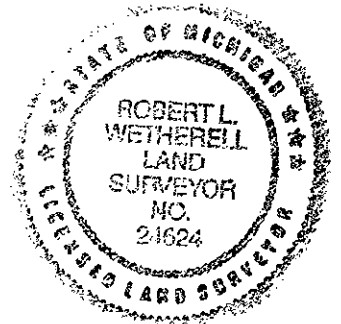

Signed by Robert L. Wetherell  
Surveyor's Michigan License No. 24624

Date April 12, 2000