

MAY 16 1997

LAND CORNER RECORDATION CERTIFICATE
Filing Requirement of Act 74, Mich. P.A. 1970

LIBER 003 PAGE 0364

For corners in Lake

Table with columns: (County), Located In: 19N, 12W, Corner Code #/K-1. Rows include Public Land Survey, Property Controlling in Section, and Miscellaneous Property in Sec.

RECORDED LAKE COUNTY, MI. SEP 12 3 10 PM '96 REGISTER OF DEEDS

Register of Deeds Stamp & File Number

4. Lot No. , Recorded Plat
5. Private Claims

Robert L. Wetherell August 19, '96

I, in a field survey on , 19 , do hereby certify that under requirements of P.A. 74, Michigan P.A. of 1970, the corner points mentioned in lines 1 and 2 above were in conformance with regulations and rules therefore as required in the current manual of survey instructions of the United States Department of the Interior, Bureau of Land Management or by a decree of a Court of Law and/or that the corner points mentioned in lines 3, 4 and 5 above were in conformance with the rules of the Michigan Board of Land Surveyors or by a Decree of a Court of Law; established, re-established, monumented, re-monumented, recovered, found as expressed below:

Grid table with columns A-M and rows 2-13. A dot is marked in the intersection of column K and row 2.


NOTE: Not more than 4 corners, all in the same town and range, may be recorded on this certificate.

A. Description of original monument and accessories and/or subsequent restoration:
K-1 - Section corner common to Sections 1 & 2, T19N, R12W, South Newkirk Twp., Lake Co., Mi.

- 1838 - S. Sibley, G.L.O. #1 - 22" Hemlock S29°W 54 Links #2 - 10" Sugar S18°W 30 Links (Closing Corner is 34 Links West)
1929 - G. Johnson, County Surveyor #3 - 24" Basswood N72°45'E 34.8' #4 - 8" Elm N18°15'W 22.3'

B. Description of corner evidence found and/or method applied in restoring or reestablishing corner:
K-1 - Section corner common to Sections 1 & 2, T19N, R12W, South Newkirk Twp., Lake Co., Mi.

I found a 1" pipe 24" long surrounded with stones. Directly under the pipe I found a large pointed stone. I also found the standard corner (1-1/4" pipe) West 21.97 feet (G.L.O. reported 34 Links). Corner is in centerline of roads East and South and 3 feet North of centerline road to West. None of the above accessories were recovered.

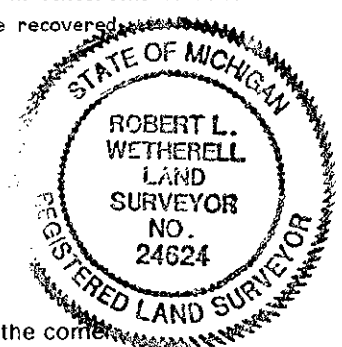

RATIFIED BY THE LAKE CO. PEER REVIEW GROUP IN ACCORDANCE WITH P.A. 345 CHAIRMAN DATE 8-27-96

C. Description of monument for corner and accessories established to perpetuate locating the position of the corner:

K-1 - Section corner common to Sections 1 & 2, T19N, R12W, South Newkirk Twp., Lake Co., Mi.

I replaced the 1" pipe with a 3/4" x 24" re-bar with a Lake County Brass Cap, and is accepted as a careful and faithful re-establishment of the position of the original corner.

- 8" R. Pine N61°W 73.26' (60d spike in S. side)
7" Spruce S69°W 59.90' (60d spike in S. side)
Power Pole S70°E 135.32' (60d spike in S. side)
3/4" Iron with Lake County Brass Cap - West 21.97' (corner common to Sections 35 & 36, T20N, R12W)

Signed by Robert L. Wetherell Date September 5, 1996

Surveyor's Michigan License No. 24624