

**LAND CORNER RECORDATION CERTIFICATE**  
Filing Requirement of Act 74, Mich. PA 1970


For Corners In:				
Lake		Located In		Corner Code #
(County)				
1. Public Land Survey		T 19N R 12W		A6
		T 19N R 13W		M6
2. Property Controlling in Section	S	T	R	
	S	T	R	
3. Miscellaneous Property in Section	S	T	R	
	S	T	R	

**Register of Deeds Stamp & File Number**

4. Lot No: \_\_\_\_\_ Recorded Plat: \_\_\_\_\_

5. Private Claims: \_\_\_\_\_

I, Craig W. McVean, in a field survey on February 6, 2001 do hereby state that under requirements of PA 74, Michigan PA of 1970, the corner points mentioned in lines 1 and 2 above were in conformance with regulations and rules therefore as required in the current manual of survey instructions of the United States Department of the Interior, Bureau of Land Management or by a decree of a Court of Law and/or that the corner points mentioned in lines 3, 4 and 5 above were in conformance with the rules of the Michigan Board of Land Surveyors or by a Decree of a Court of Law; established, re-established, monumented, recovered, found as expressed below:

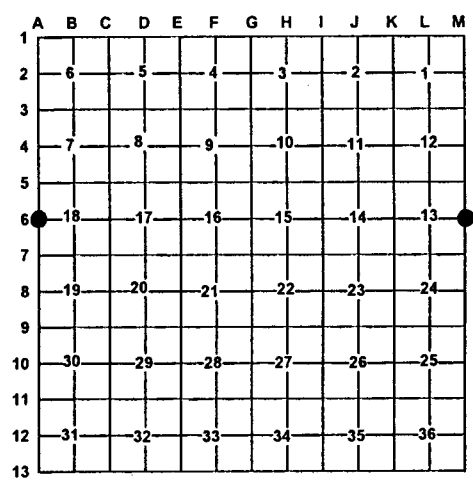

**NOTE: Not more than 2 corners, all in the same town and range, may be recorded on this certificate.**

A. Description of original monument and accessories and/or subsequent restoration:

A6 & M6 - GLO - Set 1/4 post - S. Sibley - 1838  
 Pine 8" N11°W 111 L.  
 Pine 6" S61°W 151 L.

- DNR Corner Rec. - C.F. Roser - 1969  
 Fd, 3/4" iron rod. Replaced w/ std. Dept. Mon.; 20" Oak S45°W 37.6'; 10" Oak N25°W 26.5'; 12" Oak S20°E 50.2'

- CSR - bottle & glass broken - 8" B. Oak N33°E 70  
 - F. Jones - 1935+ - B. Oak 8" S45°W 38';  
 B. Oak 10" N35°E 69.6'; B. Oak 14" N20°E 59.7'  
 J. Pine S25°W 20.1'  
 - G. Blass - 1941 - Fd. old bottle and glass as per previous survey notes. 3/4" iron rod & broken glass set by this survey.  
 16" J. Pine S25°W 19.8'; 12" B. Oak N15°E 58.6'

B. Description of corner evidence found and/or method applies in restoring or re-establishing corner:

A6 & M6 - Standard 1/4 corner common to Sec. 13, T19N, R13W and Sec. 18, T19N, R12W - Fd. 4" DOC (DNR)  
 Alum. Cap on 1" iron pipe at position used by Jones, Blass & Roser. CL of Gravel Rd. WNWly & ESE'ly is 121'± S. DOC (DNR) Mon. accepted as the best available evidence of the position of the original corner.

C. Description of monument for corner and accessories established to perpetuate locating the position of the corner:

A6 & M6 - 4" DOC (DNR) Alum. cap on 1" iron pipe.  
 Set Blue Carsonite Post 1' E  
 N30°W 26.77' to set N & T in SW side 19" B. Oak (CFR)  
 N74°W 38.03' to set N & T in S side 6" J. Pine scribed 'XBT'  
 S54°E 48.46' to set N & T in NE side 5" W. Pine scribed 'XBT'  
 N81°E 74.07' to set N & T in SE side 13" B. Oak " "



Signed by: Craig W. McVean  
 Surveyor's Michigan License No.: 39088

Date: 11/26/2001