


LAND CORNER RECORDATION CERTIFICATE
Filing Requirement of Act 74, Mich. PA 1970

For Corners In:				
Lake _____	Located In		Corner Code #	
(County)				
1. Public Land Survey	T <u>19N</u>	R <u>12W</u>	<u>C3</u>	
	T _____	R _____	_____	
2. Property Controlling in Section	S _____	T _____	R _____	_____
	S _____	T _____	R _____	_____
3. Miscellaneous Property in Section	S _____	T _____	R _____	_____
	S _____	T _____	R _____	_____
4. Lot No: _____	Recorded Plat: _____			
5. Private Claims: _____				

Register of Deeds Stamp & File Number

I, Craig W. McVean, in a field survey on May 23, 2001 do hereby state that under requirements of PA 74, Michigan PA of 1970, the corner points mentioned in lines 1 and 2 above were in conformance with regulations and rules therefore as required in the current manual of survey instructions of the United States Department of the Interior, Bureau of Land Management or by a decree of a Court of Law and/or that the corner points mentioned in lines 3, 4 and 5 above were in conformance with the rules of the Michigan Board of Land Surveyors or by a Decree of a Court of Law; established, re-established, monumented, recovered, found as expressed below:

NOTE: Not more than 2 corners, all in the same town and range, may be recorded on this certificate.

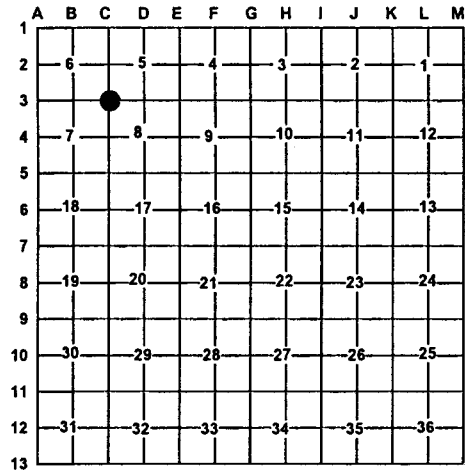

A. Description of original monument and accessories and/or subsequent restoration:

- | | |
|---|--|
| <p><u>C3</u> - GLO - Set post - S. Sibley - 1838
Pine 8" S6°W 38 L.
Pine 6" N89°W 44 L.
- F. Jones - 1930's
B. Oak 7" S56°E 25' 1"
B. Oak 6" S56°W 27' 11"
- Twin Creek Plat - Drawer of plats No. 2
R.D. McNutt - 1950
- Twin Creek Plat No. 2- L. 35 Tract index, P. 181
R.D. McNutt - 1952</p> | <p>- LCRC - L. 2, P. 184 - C. Cole - 1973
Reset from plat of Twin Creek #1
8" J. Pine N48°E 82.84'; 18" R. Oak S54°E 57.34';
P. Pole N58°E 61.55'; P. Pole S32°W 57.79'
- LCRC - L. 2, P. 385 - C.F. Roser - 1980
Fd. RR spike in Bit. Rd. as previously used by RLS C. Cole & G. Blass. Corner is in line with center rd. N.
11" J. Pine N45°W 82.82'
PP N60°E 61.54'
19" B. Oak S50°E 57.30'
PP S35°W 57.82'</p> |
|---|--|

B. Description of corner evidence found and/or method applies in restoring or re-establishing corner:

C3 - Sec. Cor. common to Sections 5, 6, 7 & 8 - Fd. R.R. spike in CL of E.- W. bit Rd. per Cole & Roser. CL of Gravel Rd N. is 4' +/- W. No evidence of Jones BT's. Fd. 2 newer looking U. Poles that fit Cole & Roser's witness ties. R.R. spike accepted as the best available evidence of the position of the original corner.

C. Description of monument for corner and accessories established to perpetuate locating the position of the corner:

C3 - Replaced R.R. spike w/ 2" Alum. Cap on 5/8" x 34" Rebar in Mon. Box South 33.13' to Fd. 1/2" iron rod & set Orange Carsonite Post w/ loc. tag S30°W 57.58' to set N & T in E. side UP (CC, CFR) N60°E 61.55' to set N & T in S. side UP (CC, CFR) N42°E 101.39' to SW Cor, Blk. HSE. N78°W 124.76' to set N & T in S side 19" W. Oak



Signed by: Craig W. McVean
Surveyor's Michigan License No.: 39088

Date: 11/26/2001