


LAND CORNER RECORDATION CERTIFICATE


Filing Requirement of Act 74, Mich. PA 1970

For Corners In: Lake _____ (County) _____	Located In T <u>19N</u> R <u>12W</u> T _____ R _____ S _____ T _____ R _____ S _____ T _____ R _____	Corner Code # <u>E3</u> _____ _____ _____ _____	
4. Lot No: _____ Recorded Plat: _____			
5. Private Claims: _____			

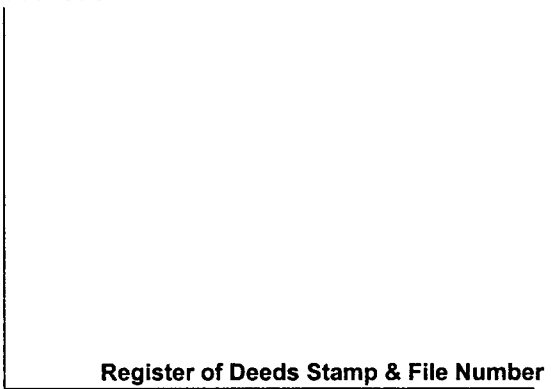

I, Craig W. McVean, in a field survey on May 23, 2001 do hereby state that under requirements of PA 74, Michigan PA of 1970, the corner points mentioned in lines 1 and 2 above were in conformance with regulations and rules therefore as required in the current manual of survey instructions of the United States Department of the Interior, Bureau of Land Management or by a decree of a Court of Law and/or that the corner points mentioned in lines 3, 4 and 5 above were in conformance with the rules of the Michigan Board of Land Surveyors or by a Decree of a Court of Law; established, re-established, monumented, recovered, found as expressed below:

NOTE: Not more than 2 corners, all in the same town and range, may be recorded on this certificate.

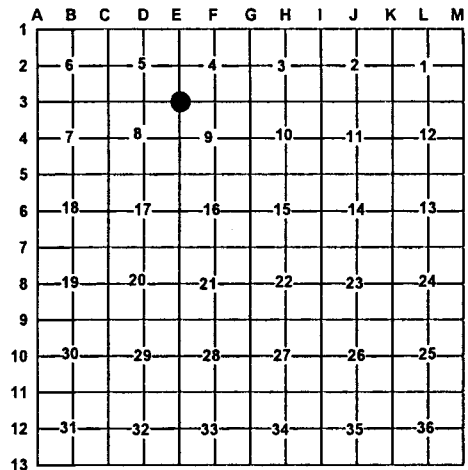

A. Description of original monument and accessories and/or subsequent restoration:

- | | |
|---|---|
| <p><u>E3</u> - GLO - Set 1/4 post - S. Sibley - 1838
 Pine 12" N44°E 61 L.
 Pine 8" S69°W 10 L.</p> <p>- G.H. Johnson notes - Fd. old stake & wit. trees.
 Set 3/4" x 24" bolt.
 Y. Pine 12" S27°E 10 1/2
 J. Pine 8" N66°E 37 1/2
 B. Oak 7" N54°E 94
 B. Oak 9" N7°E 71
 B. Oak 7" S44°E 66.4</p> | <p>- LCRC - L. 2, P. 184 - C. Cole - 1973 - 3/4" iron bar w/ sq. head.
 12" B. Oak S11°E 42.83'; 12" W. Pine N3°W 99.26';
 4" W. Pine S58°W 104.28'</p> <p>- LCRC - L. 2, P. 385 - C.F. Roser - 1980
 Fd. bolt as indicated in Geo. Johnson old survey notes.
 Corner is 1' N of CL. E-W B' top rd. Raised bolt w/ 3/4" x 12" pipe.
 15" W. Pine N5°W 99.25'; 14" B. Oak S10°E 42.83'; 4" W. Pine
 S60°W 104.28'; Ctr. Rd. S due W. 35'
 Set cedar post w/ loc. tag N45°E 47'</p> |
|---|---|

B. Description of corner evidence found and/or method applies in restoring or re-establishing corner:

E3 - Sec. Cor. common to Sections 4, 5, 8 & 9 - Fd. 3/4" iron pipe at surface of E-W Bit. Rd. - 1.5' N of CL. - per Roser's LCRC. CL. of Gravel Rd. S is 35' W. Fd. stps. of Roser & Coles South witnesses that fit corner position. Johnson indicates he perpetuated original corner position here. 3/4" iron pipe over bolt is accepted as a careful & faithful perpetuation of the position of the original corner.

C. Description of monument for corner and accessories established to perpetuate locating the position of the corner:

E3 - 3/4" iron pipe at bit. surface.
 N45°E 47' to set Blue Carsonite Post w/ loc. tag & reset cedar post w/ loc. tag
 N5°W 99.20' to set S & T in W. side 22" W. Pine (CC, CFR)
 S42°W 124.43' to set N & T in E. side 7" W. Pine scribed 'XBT'
 N60°W 64.93' to set N & T in SW side 14" W. Oak scribed 'XBT'
 S24°E 99.92' to set N & T in NE side 6" W. Pine scribed 'XBT'



Signed by: Craig W. McVean
 Surveyor's Michigan License No.: 39088

Date: 11/26/2001